
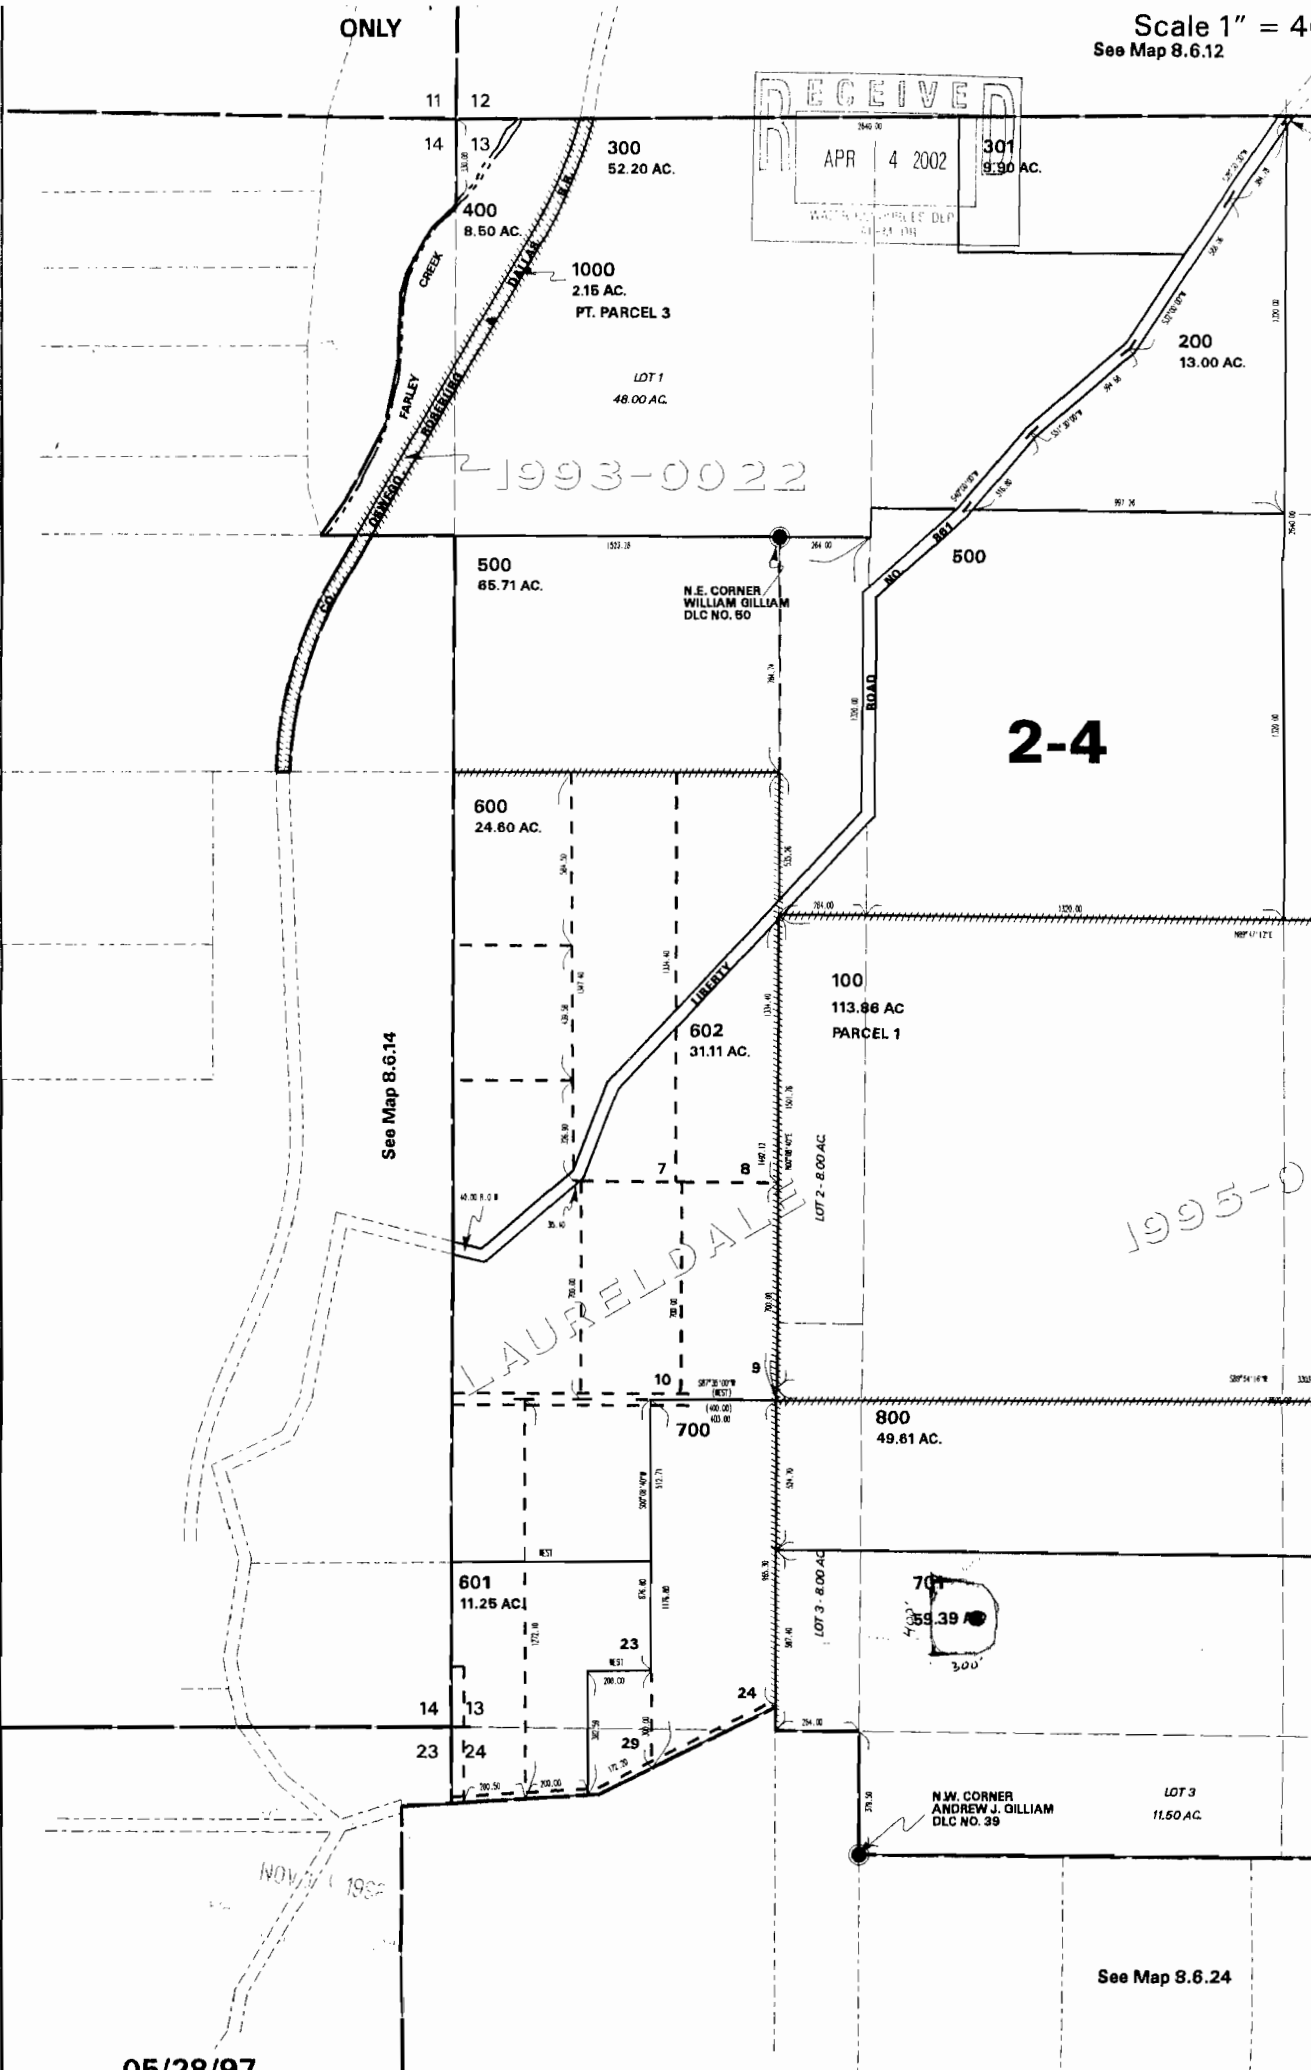


ONLY

Scale 1" = 40'
See Map 8.6.12

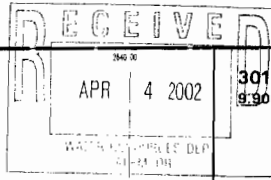

1993-0022

2-4

1995-00

See Map 8.6.14

See Map 8.6.24

NOV 1982

05/28/97

300
52.20 AC.

11

12

14

13

1000
2.15 AC.
PT. PARCEL 3

LOT 1
48.00 AC.

200
13.00 AC.

500
65.71 AC.

N.E. CORNER
WILLIAM GILLIAM
DLC NO. 50

500

600
24.60 AC.

100
113.86 AC
PARCEL 1

602
31.11 AC.

LOT 2 - 8.00 AC.

601
11.25 AC.

701
59.39 AC.

N.W. CORNER
ANDREW J. GILLIAM
DLC NO. 39

LOT 3
11.50 AC.

700
49.81 AC.

14

13

23

24

23

24

29