


TOWNSHIP 12 SOUTH, RANGE 40 EAST, W.M.

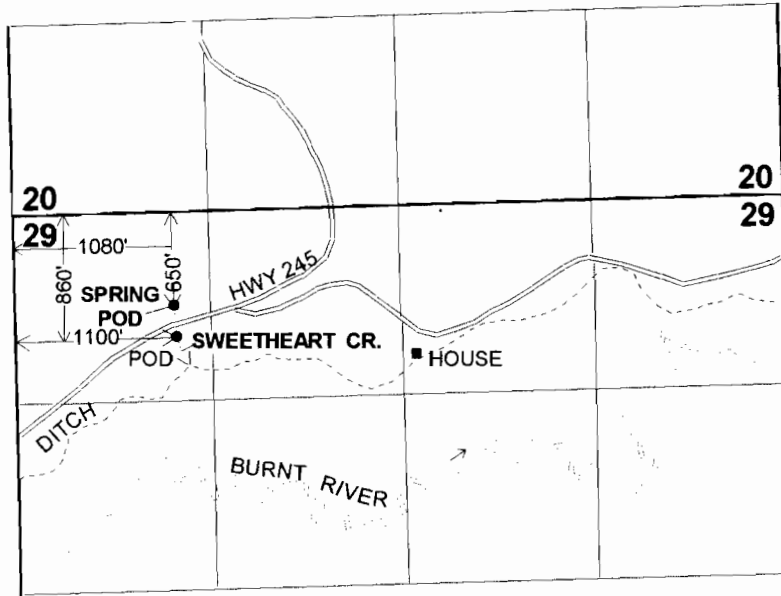

1" = 1320'

FINAL PROOF SURVEY

UNDER

Application No. 55134 Permit No. 41337

IN THE NAME OF

VICTOR BRUNO

Surveyed: August 14, 2000 by: J. Miller

RECEIVED

MAR 03 2003

WATER RESOURCES DEPT
SALEM, OREGON