


T. 6 S., R. 44 E., W.M.

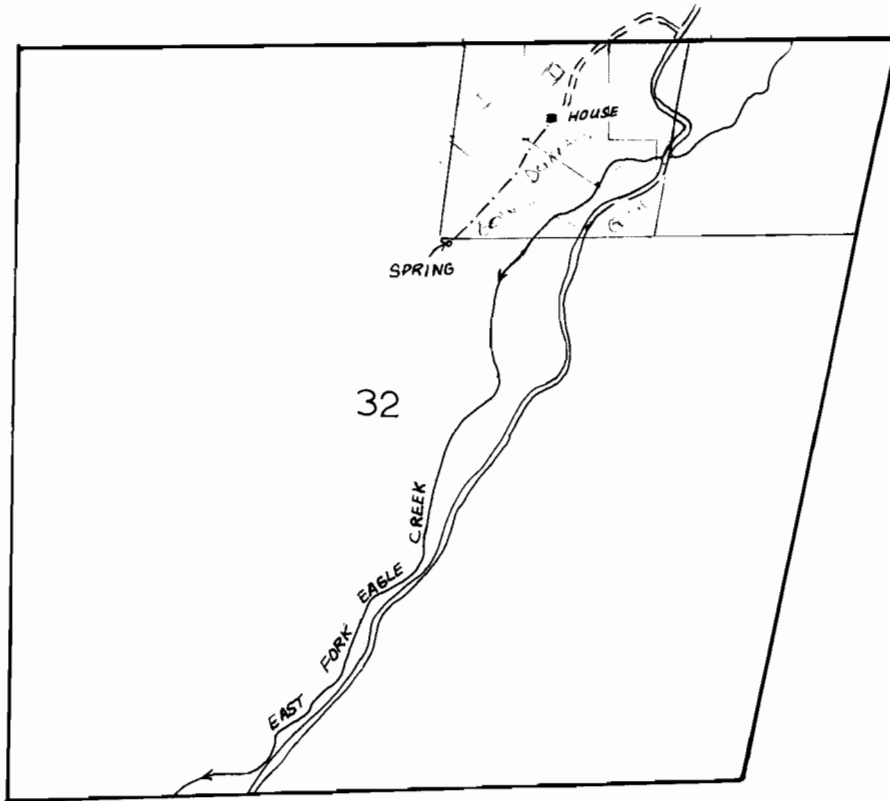

1" = 1320'

POD - 1400' S. AND 40' E. FROM N. 1/4 COR. SEC. 32.

FINAL PROOF SURVEY
UNDER

Application No. 64996 Permit No. 47464
IN NAME OF

MARIE BLANK

Surveyed 9-16, 1993, by J. MILLER