THIS MAP WAS PREPARED FOR ASSESSMENT PURPOSE ONLY

# NW1/4 SW1/4 SEC. 33 T.8S. R.37E. W.M.
## BAKER COUNTY

1" = 100'

8 37 33CE

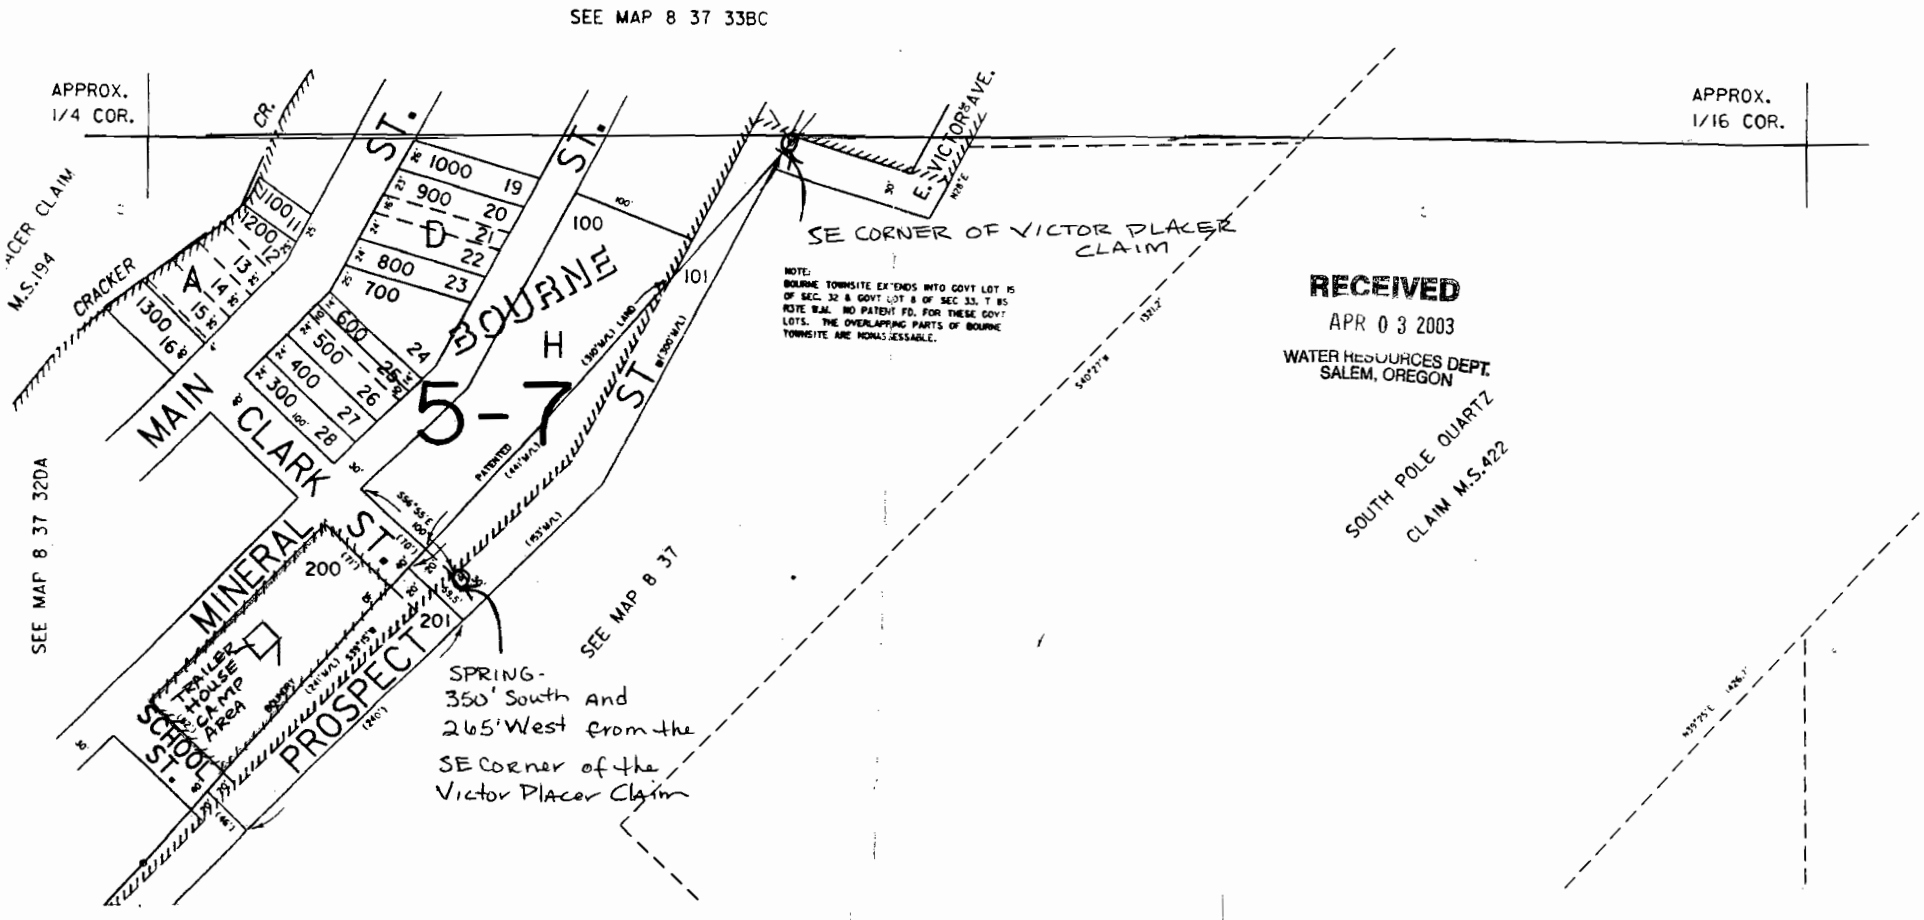


**FINAL PROOF SURVEY**
UNDER
**Application No. 52427 Permit No. 41305**

IN THE NAME OF
**JESSIE I. CLAYTON**
Surveyed: August 31, 2000 by: J. Miller