


T. 26 S., R. 9 E., W.M.

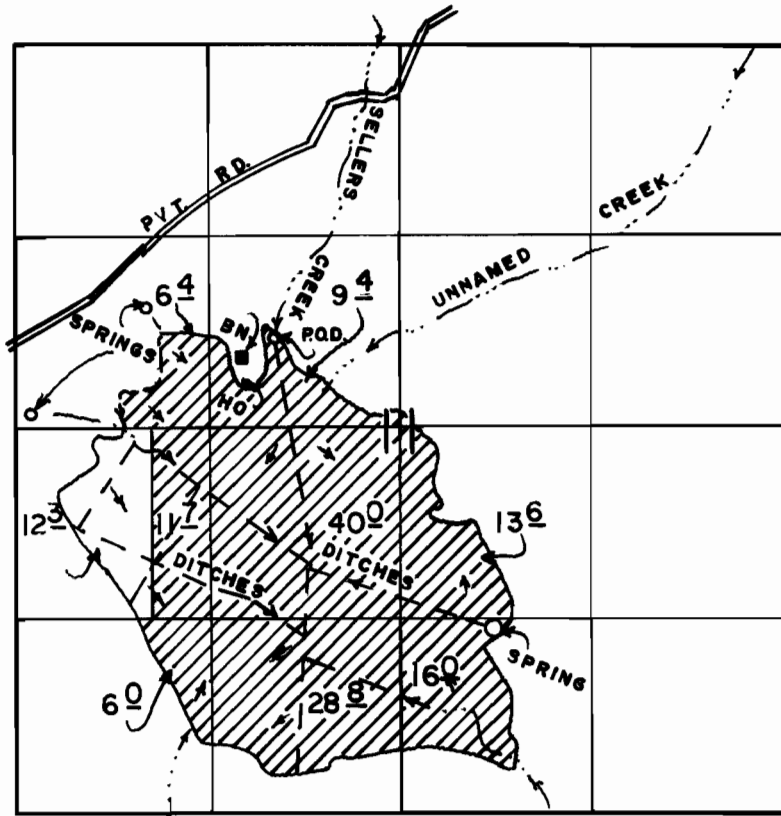

P.O.D. LOC: 2000'S & 1780'E FROM NW COR. OF SEC 11.

SCALE: 1" = 1320'

FINAL PROOF SURVEY

UNDER

Application No. 46254 Permit No. 34558
IN NAME OF

LOWE, INC.

Surveyed JULY 13, 1994, by R.M.SUTTERFIELD