



TOWNSHIP 3 SOUTH, RANGES 40 & 41 EAST, W.M.

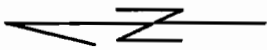

1" = 1320'

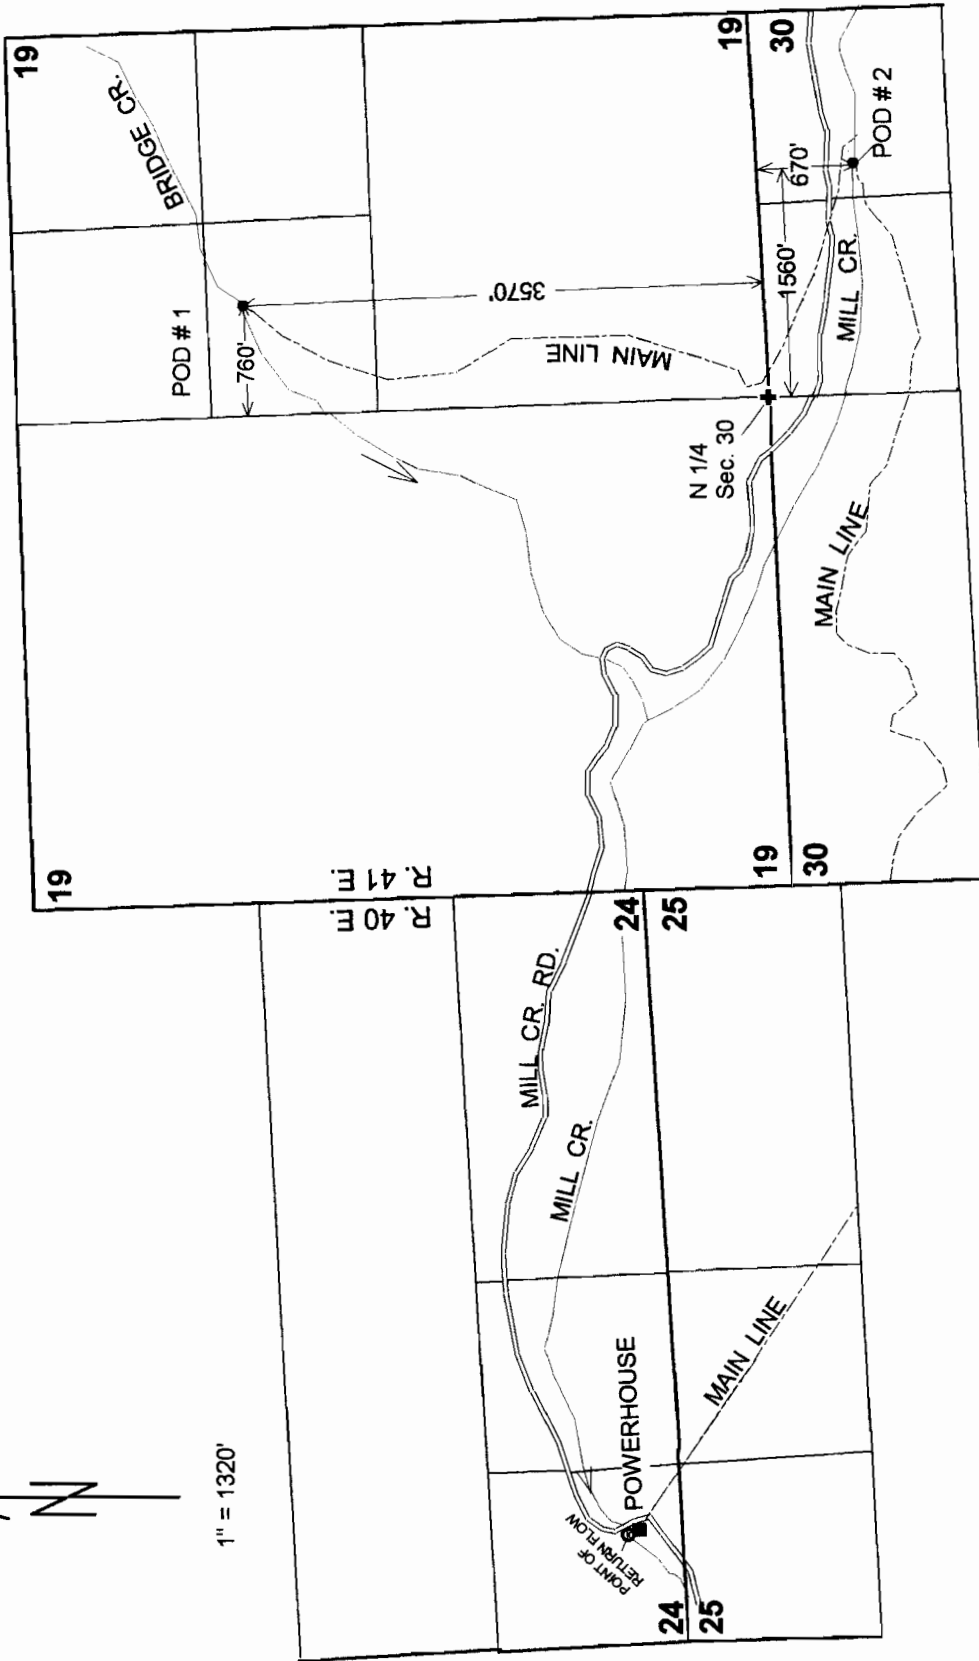

FINAL PROOF SURVEY
 UNDER
 Application 62983 Permit 48505
 IN THE NAME OF
 CITY OF COVE
 Surveyed: August 28, 2002 by: J. Miller

RECEIVED
 FEB 03 2003
 WATER RESOURCES DEPT.
 SALEM, OREGON