


T. 28 S., R. 14 E., W.M.

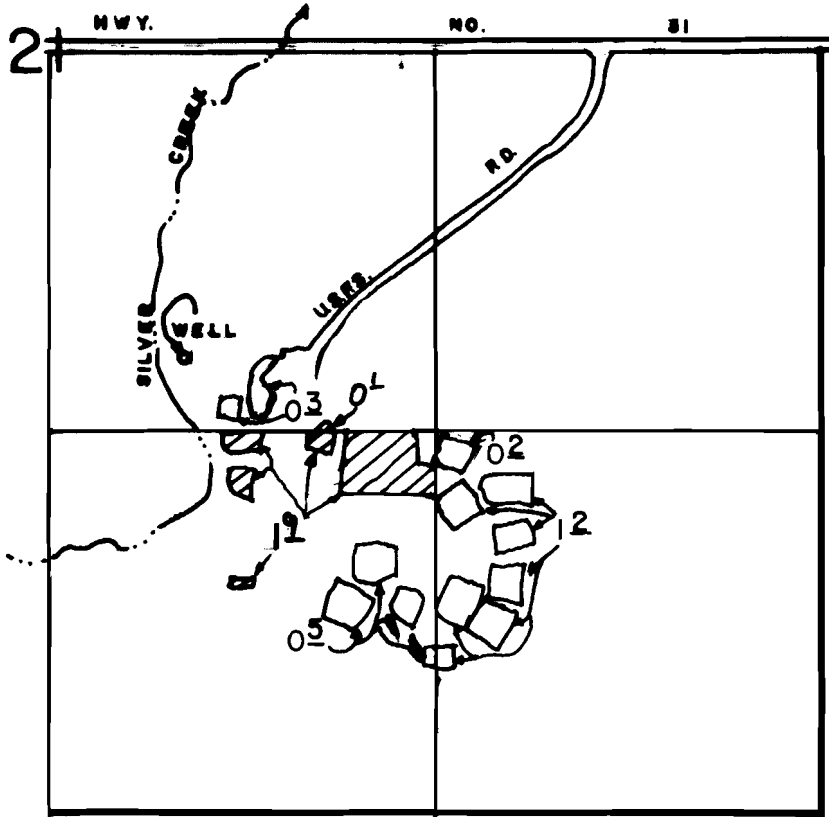

FEB - 8 1994

WATER RESOURCES DEPT.
DALEM, OREGON

WELL LOC: 1550' N & 470' E FROM S 1/4 COR. SEC 21.

SCALE: 1" = 660'

FINAL PROOF SURVEY

UNDER

Application No. G-11617 Permit No. G-10784
IN NAME OF

FREMONT NATIONAL FOREST

Surveyed JUNE 2, 1993, by R.M.SUTTERFIELD