


T. 4 N., R. 36 E., W.M.

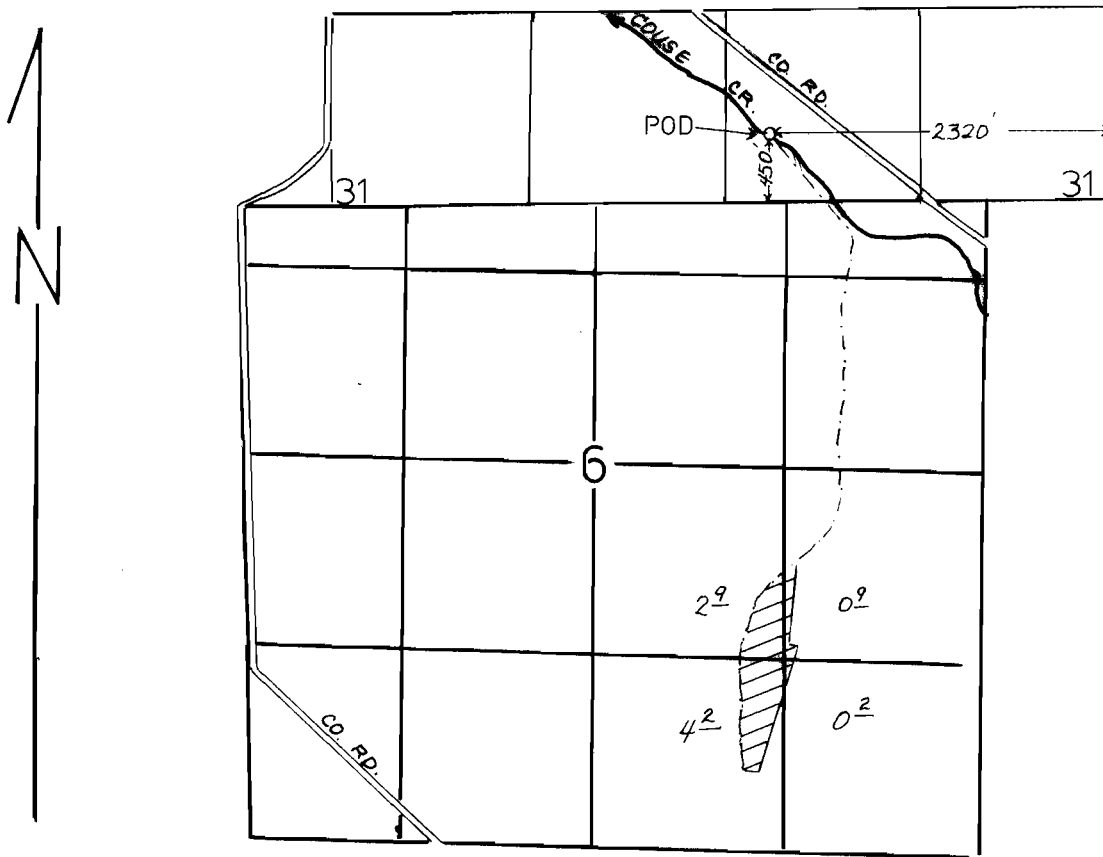

1" = 1320'

FINAL PROOF SURVEY

UNDER

Application No. 69187 Permit No. 50212
IN NAME OF

EMILY SHUMWAY BANKS

Surveyed April 29, 1994, by J. Miller