


T. 1 N. & 1 S., R. 26 E., W.M.

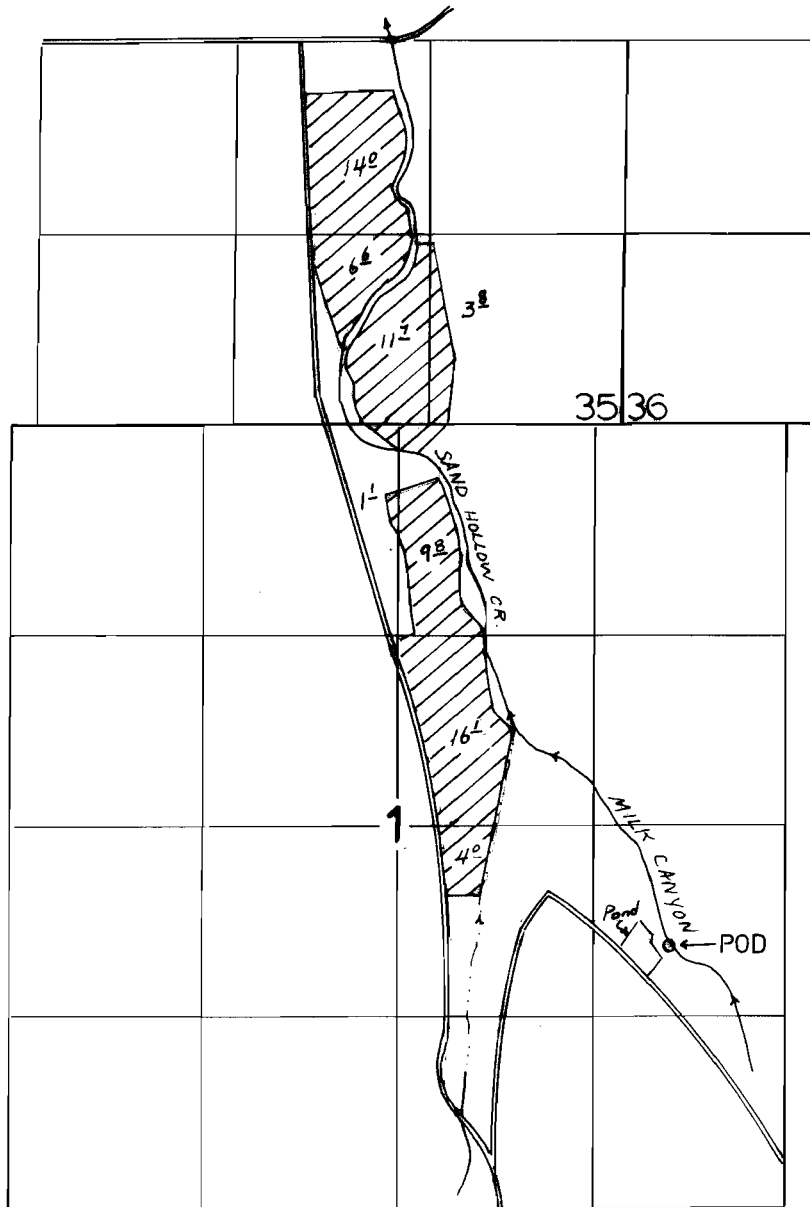

POD - 840' S. & 1790' E. FROM THE CENTER COR. SECTION 1.

## FINAL PROOF SURVEY

UNDER

Application No. 68404 Permit No. 49456

IN NAME OF

FRITZ CUTSFORTH

Surveyed 11-20, 1991, by J. MILLER