


T. 1 N., R. 27 E., W.M.

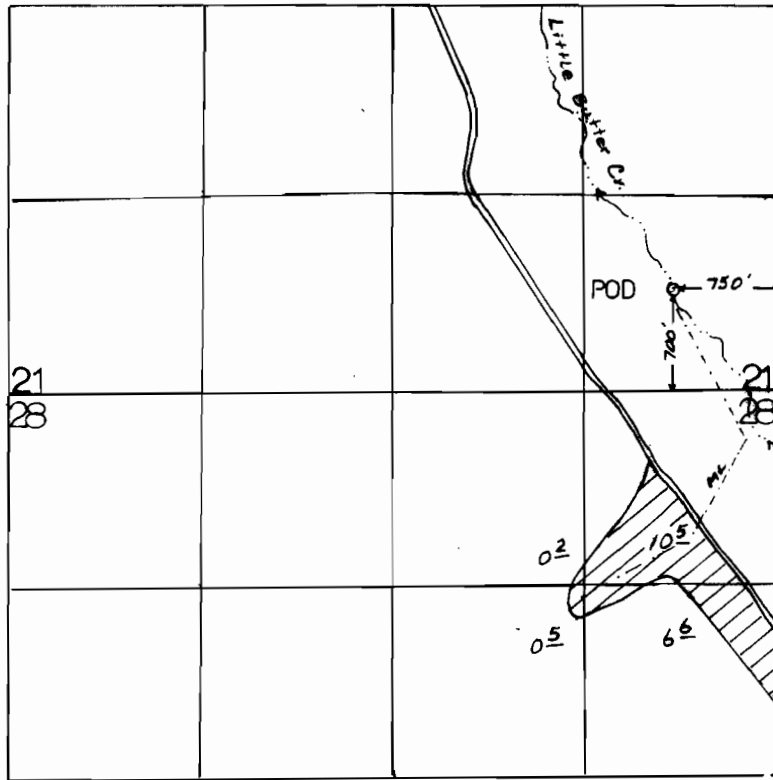

**FINAL PROOF SURVEY**

UNDER

Application No. 59358 Permit No. 44615  
IN NAME OF

DWIGHT L. BAILEY

Surveyed 4-30, 1992, by J. MILLER