


T. 4 N., R. 32 E., W.M.

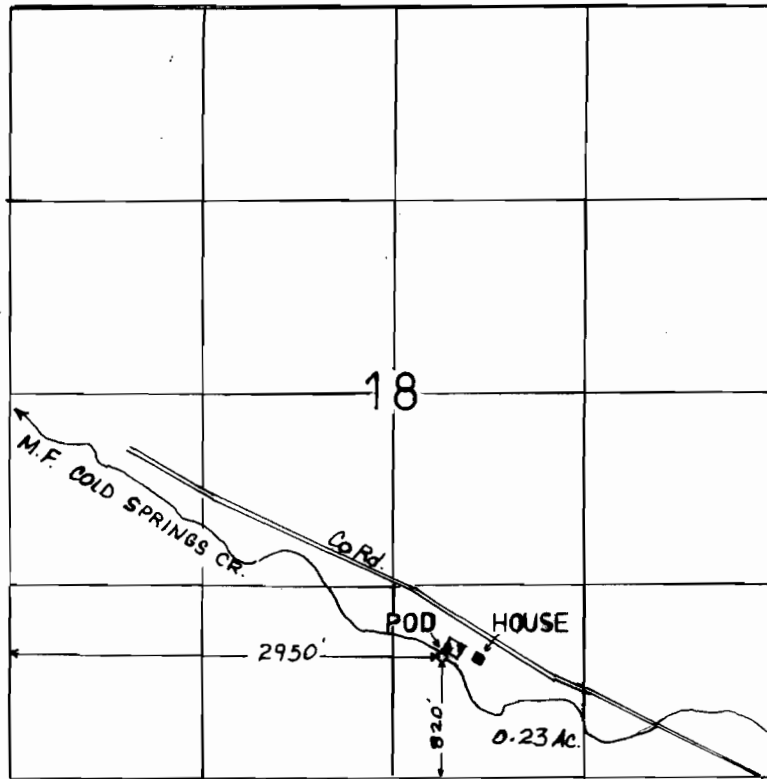

1" = 1320'

FINAL PROOF SURVEY

UNDER

Application No. 41642 Permit No. 30748
IN NAME OF

JOHN W. AND GERALDINE SPRINGSTEEN

Surveyed JANUARY 25, 1994, by J. Miller