


# T. 5 N., R 29 E., W. M.

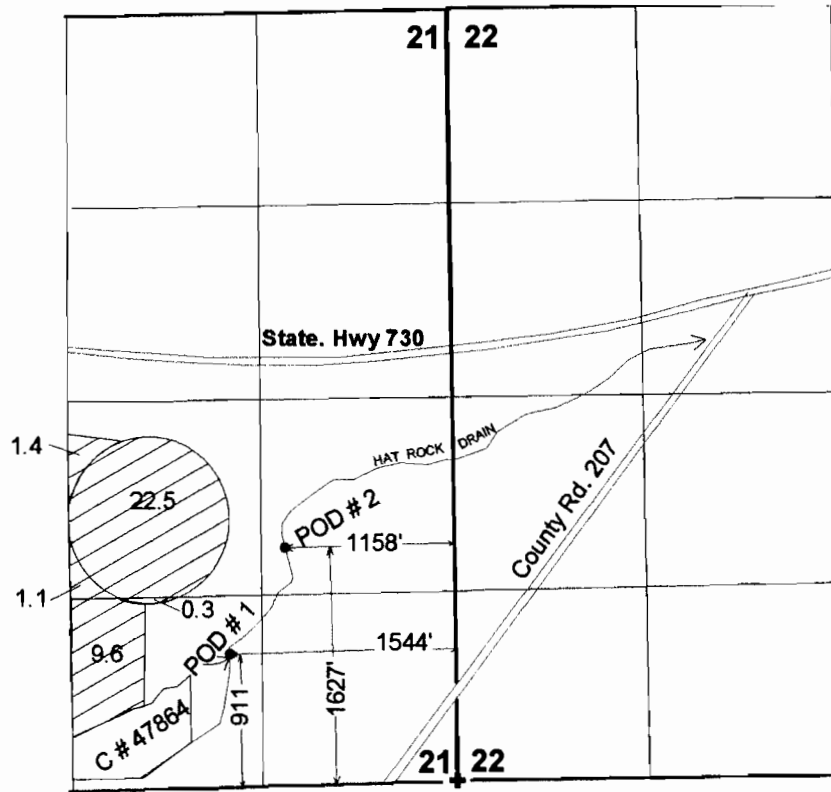

1" = 1320'

## FINAL PROOF SURVEY

UNDER

Application No. 65080 Permit No. 47810

IN THE NAME OF

DAVID H. AND REGINA M. MARKS

Surveyed 07-27-2001, by J. Miller

### RECEIVED

JAN 02 2002

WATER RESOURCES DEPT.  
SALEM, OREGON