


T. 6 N., R. 34 & 35 E., W.M.

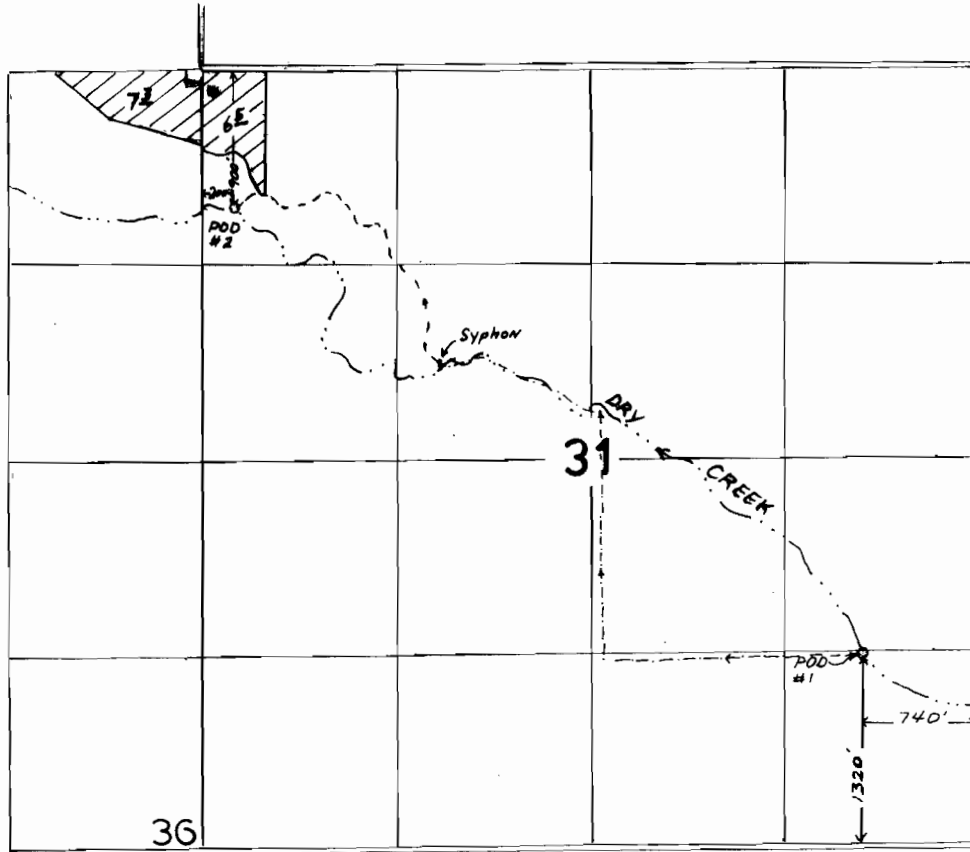

R 34 E
R 35 E

FINAL PROOF SURVEY

UNDER

Application No. 61522 Permit No. 45713

IN NAME OF

LEONARD KEY

Surveyed 7-29, 1993, by J. MILLER