


T. 1 N., R. 35 E., W.M.

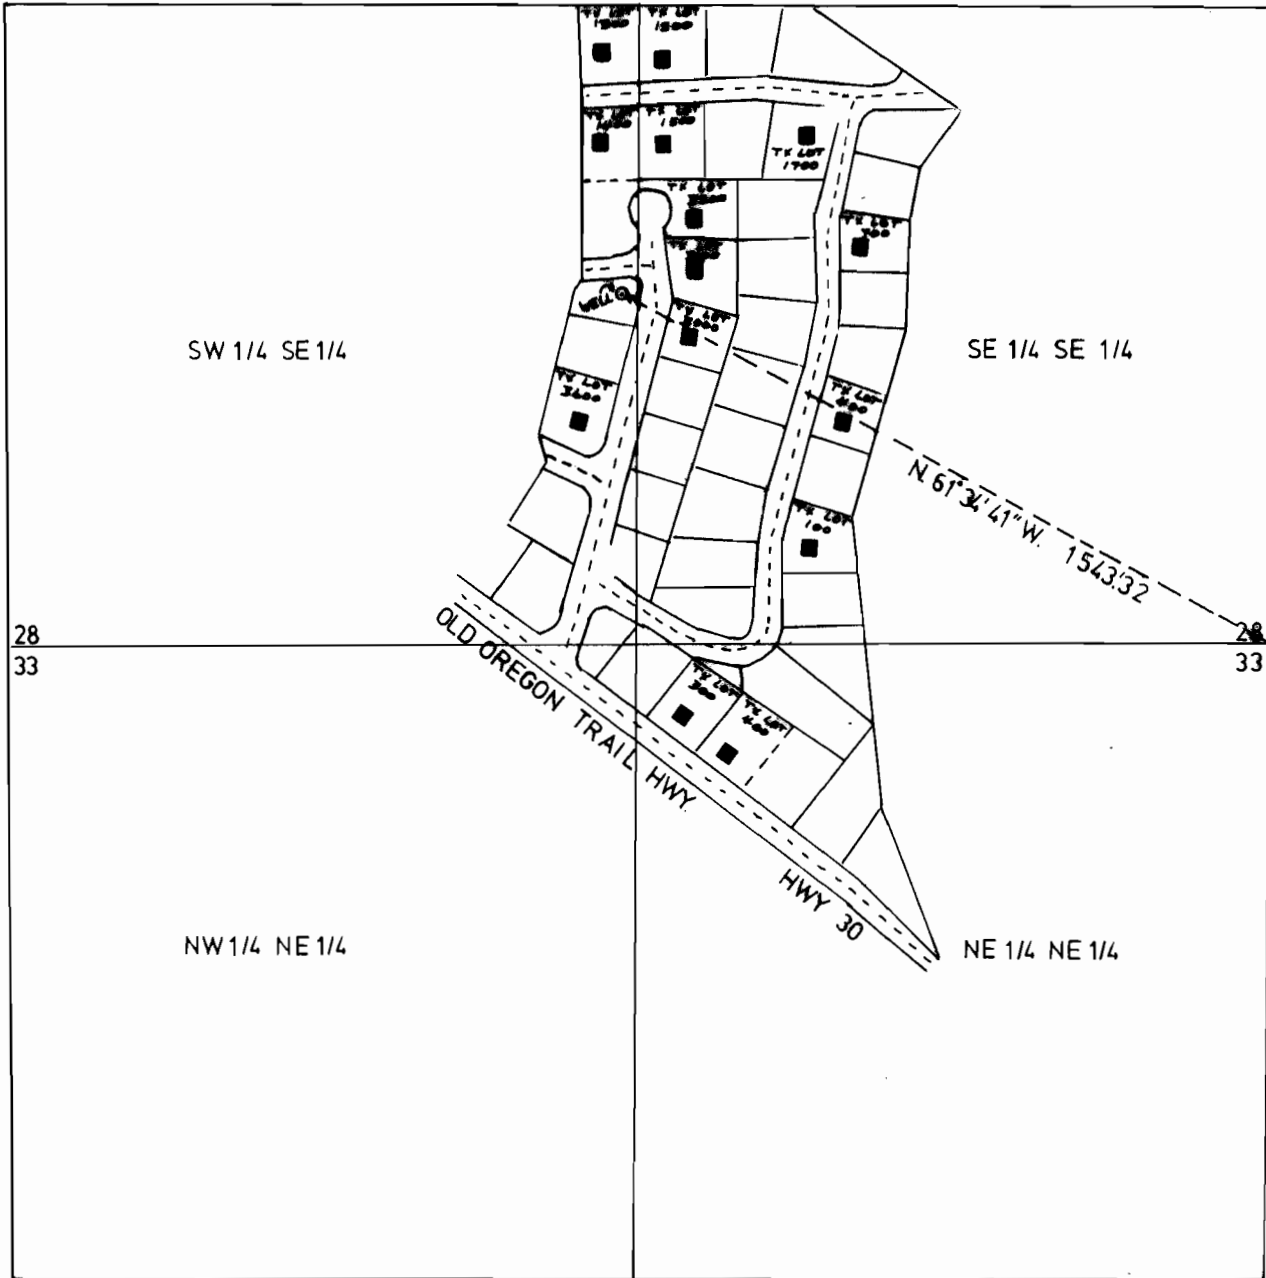

FINAL PROOF SURVEY

UNDER

Application No. G-4955 Permit No. G-4677
IN NAME OF

PAPOOSE WOODLANDS WATER COMPANY

Surveyed 7-24, 1992, by J. MILLER