
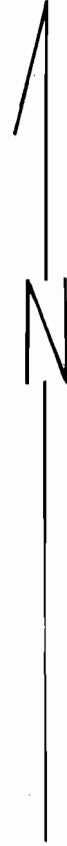


T. 6 N., R. 35 E., W.M.

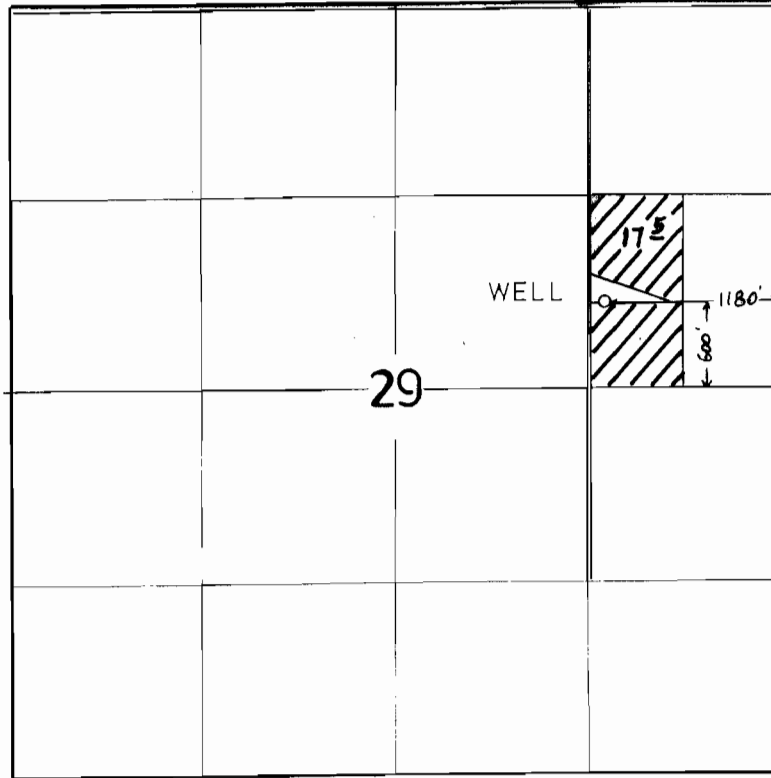

1" = 1320'

FINAL PROOF SURVEY

UNDER

Application No. G-11628 Permit No. G-10749
IN NAME OF

RICHARD E. AND RITA D. HERMANN

Surveyed July 22, 1992 by J. Miller