


# T. 2 N., R. 32 E., W.M.

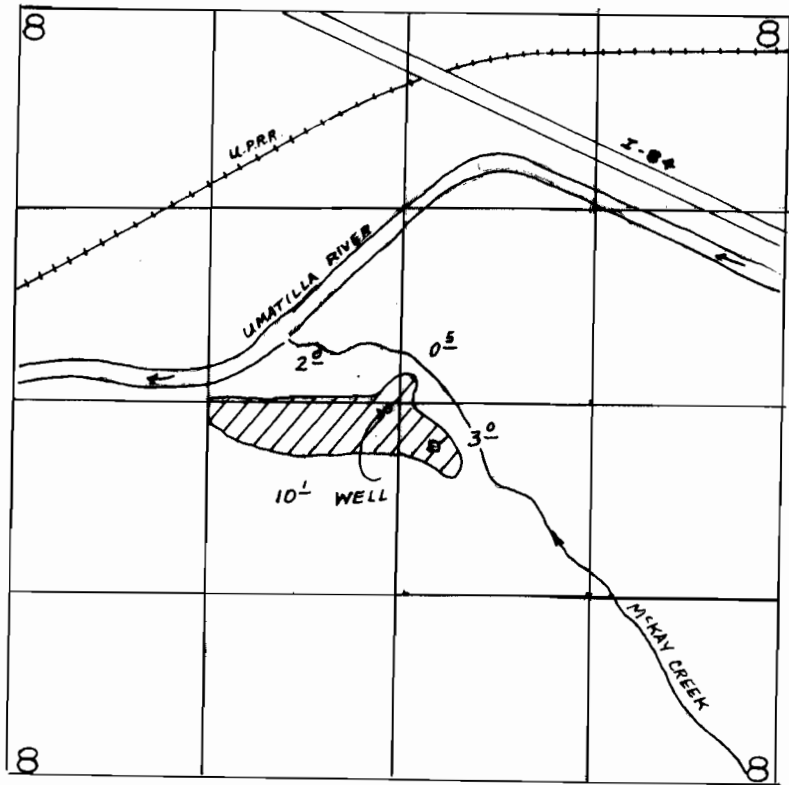

1" = 1320'

WELL - 50' S. AND 80' W. FROM THE GEN. COR. SEC. 8.

## FINAL PROOF SURVEY

UNDER

Application No. G-11403 Permit No. G-10510  
IN NAME OF

DONALD AND VALOYCE WRIGHTSON

Surveyed 7-24, 1992, by J. MILLER