


T. 5 N., R. 32 E., W.M.

RECEIVED

SEP - 4 1997

WATER RESOURCES DEPT.
SALEM, OREGON

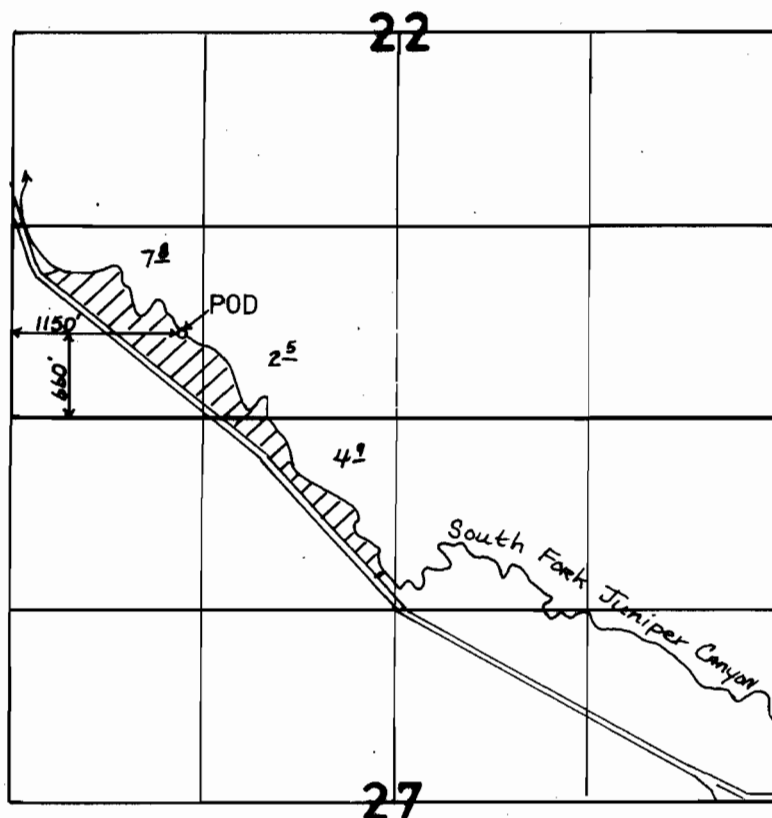

FINAL PROOF SURVEY
UNDER

Application No. 69018 Permit No. 49973
IN NAME OF

WILLIAM G. HOLTON

Surveyed August 12, 1994, by J. Miller