


T. 5 N., R. 36 E., W.M.

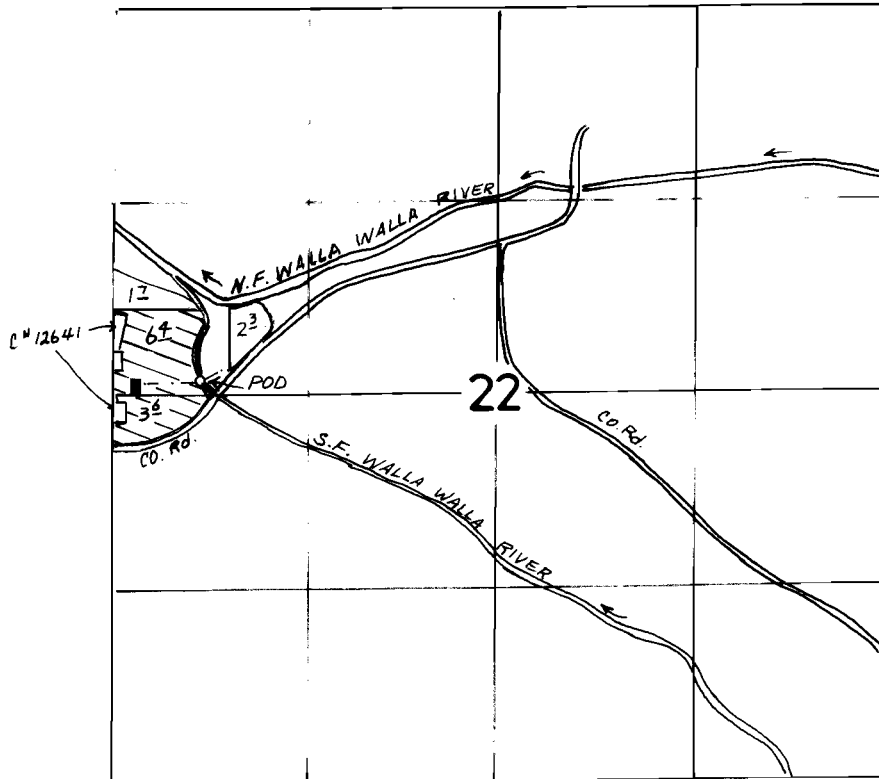

1" = 1320'

POD - 100' N. AND 570' E. FROM THE W 1/4 COR. SEC. 22.

FINAL PROOF SURVEY

UNDER

Application No. 62252 Permit No. 46544

IN NAME OF

WALLACE F. BULLOCK

Surveyed 7-14, 1993, by J. MILLER