


T. 15 & 16 S., R. 8 W., W.M.

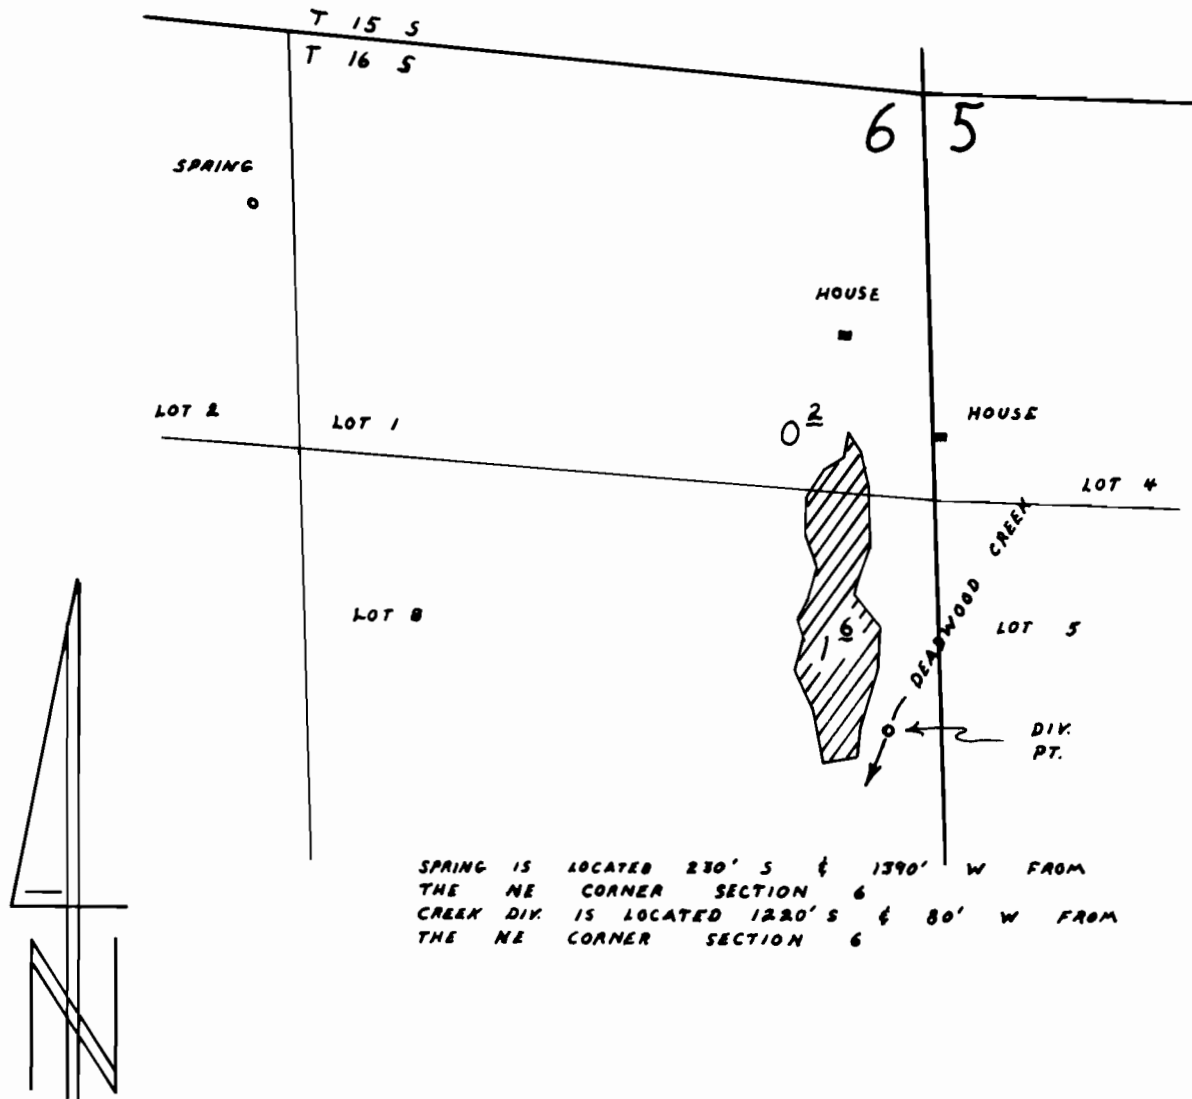

SPRING IS LOCATED 230' S & 1390' W FROM
THE NE CORNER SECTION 6
CREEK DIV. IS LOCATED 1220' S & 80' W FROM
THE NE CORNER SECTION 6

1" = 400'

FINAL PROOF SURVEY

UNDER

Application No. 68540 Permit No. 49477
IN NAME OF

Donald G. Carlton

Surveyed September 18, 1990, by Ken Kemp