


T. 4 N., R. 29 E., W.M.

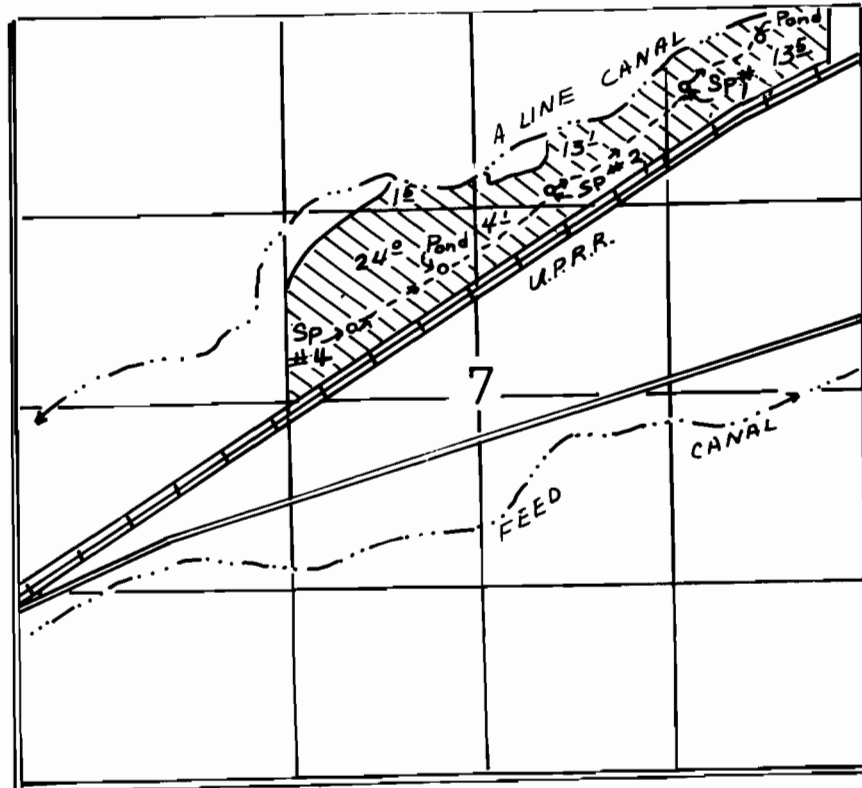

1" = 1320'

SPRING 1 POD - 550' S. & 1250' W.
SPRING 2 POD - 1230' S. & 2150' W. } ALL FROM THE NE COR. SEC. 7.
SPRING 4 POD 2150' S & 3525' W.

FINAL PROOF SURVEY

UNDER

Application No. 49637 Permit No. 41304
IN NAME OF

LEON KENNEDY

Surveyed MAY 19, 1998, by J. MILLER