


**Township 5 N., Range 28 E., W.M.**

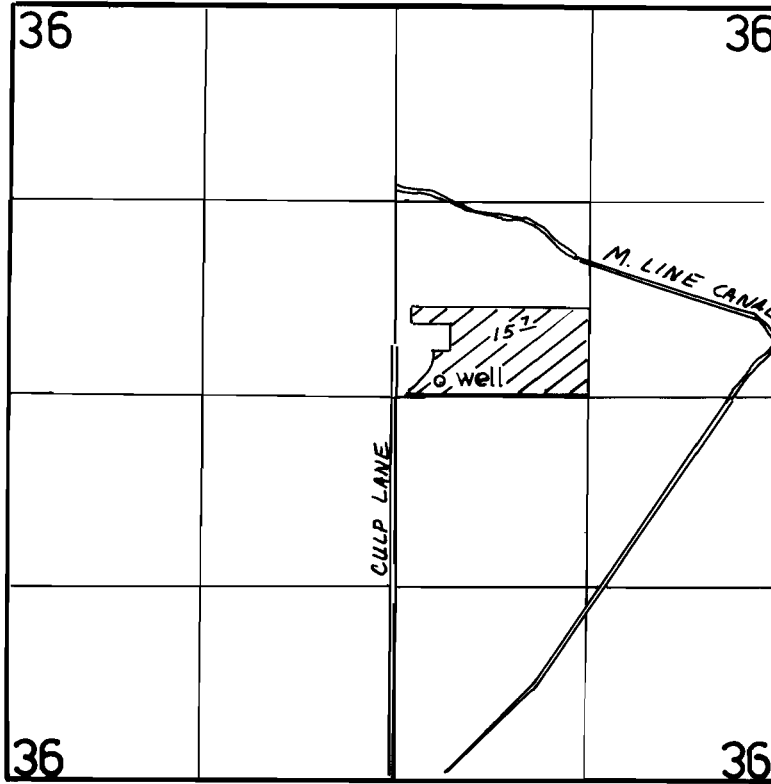

WELL 100' N. & 330' E. FROM CENTER COR. SEC. 36

1" = 1320'

**FINAL PROOF SURVEY  
UNDER**

Application No. G-10798 Permit No. G-9903  
**IN NAME OF**

K. Neal Christopherson and Pam Christopherson

Surveyed April 29 99, by J. Miller