


T. 2 N., R. 34 E., W.M.

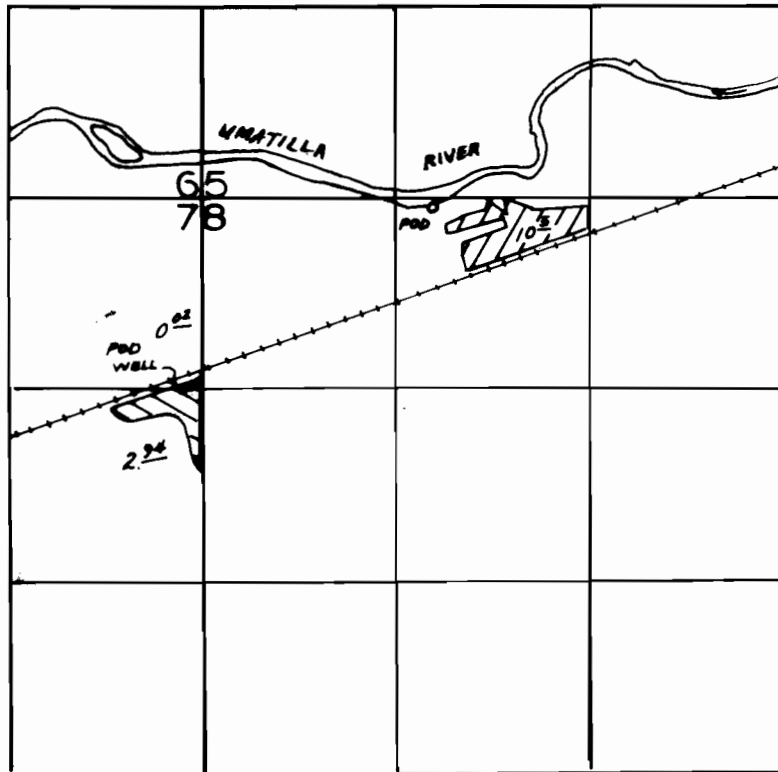

1" = 1320'

POD WELL - 1280' S. AND 100' W. FROM NW COR. SEC. 8.
POD UMATILLA - 50' S. AND 1575' E. FROM NW COR. SEC. 8

-  WELL IRRIGATION
-  RIVER IRRIGATION

FINAL PROOF SURVEY UNDER

Application No. **63264** Permit No. **47406**
G-10660 G-10069
IN NAME OF

CLINTON C. CASE

Surveyed **6-22, 1922**, by **V. CHURCH**