

SE1/4 SEC. 7 T.4N. R.4W. W.M.

4 4 7 4

COLUMBIA COUNTY

THIS MAP HAS BEEN PREPARED FOR ASSESSMENT PURPOSES ONLY


Scale: 1" = 200'

Current Revision Date:

8 / 31 / 90

SEE MAP 4 4 7

RIVER

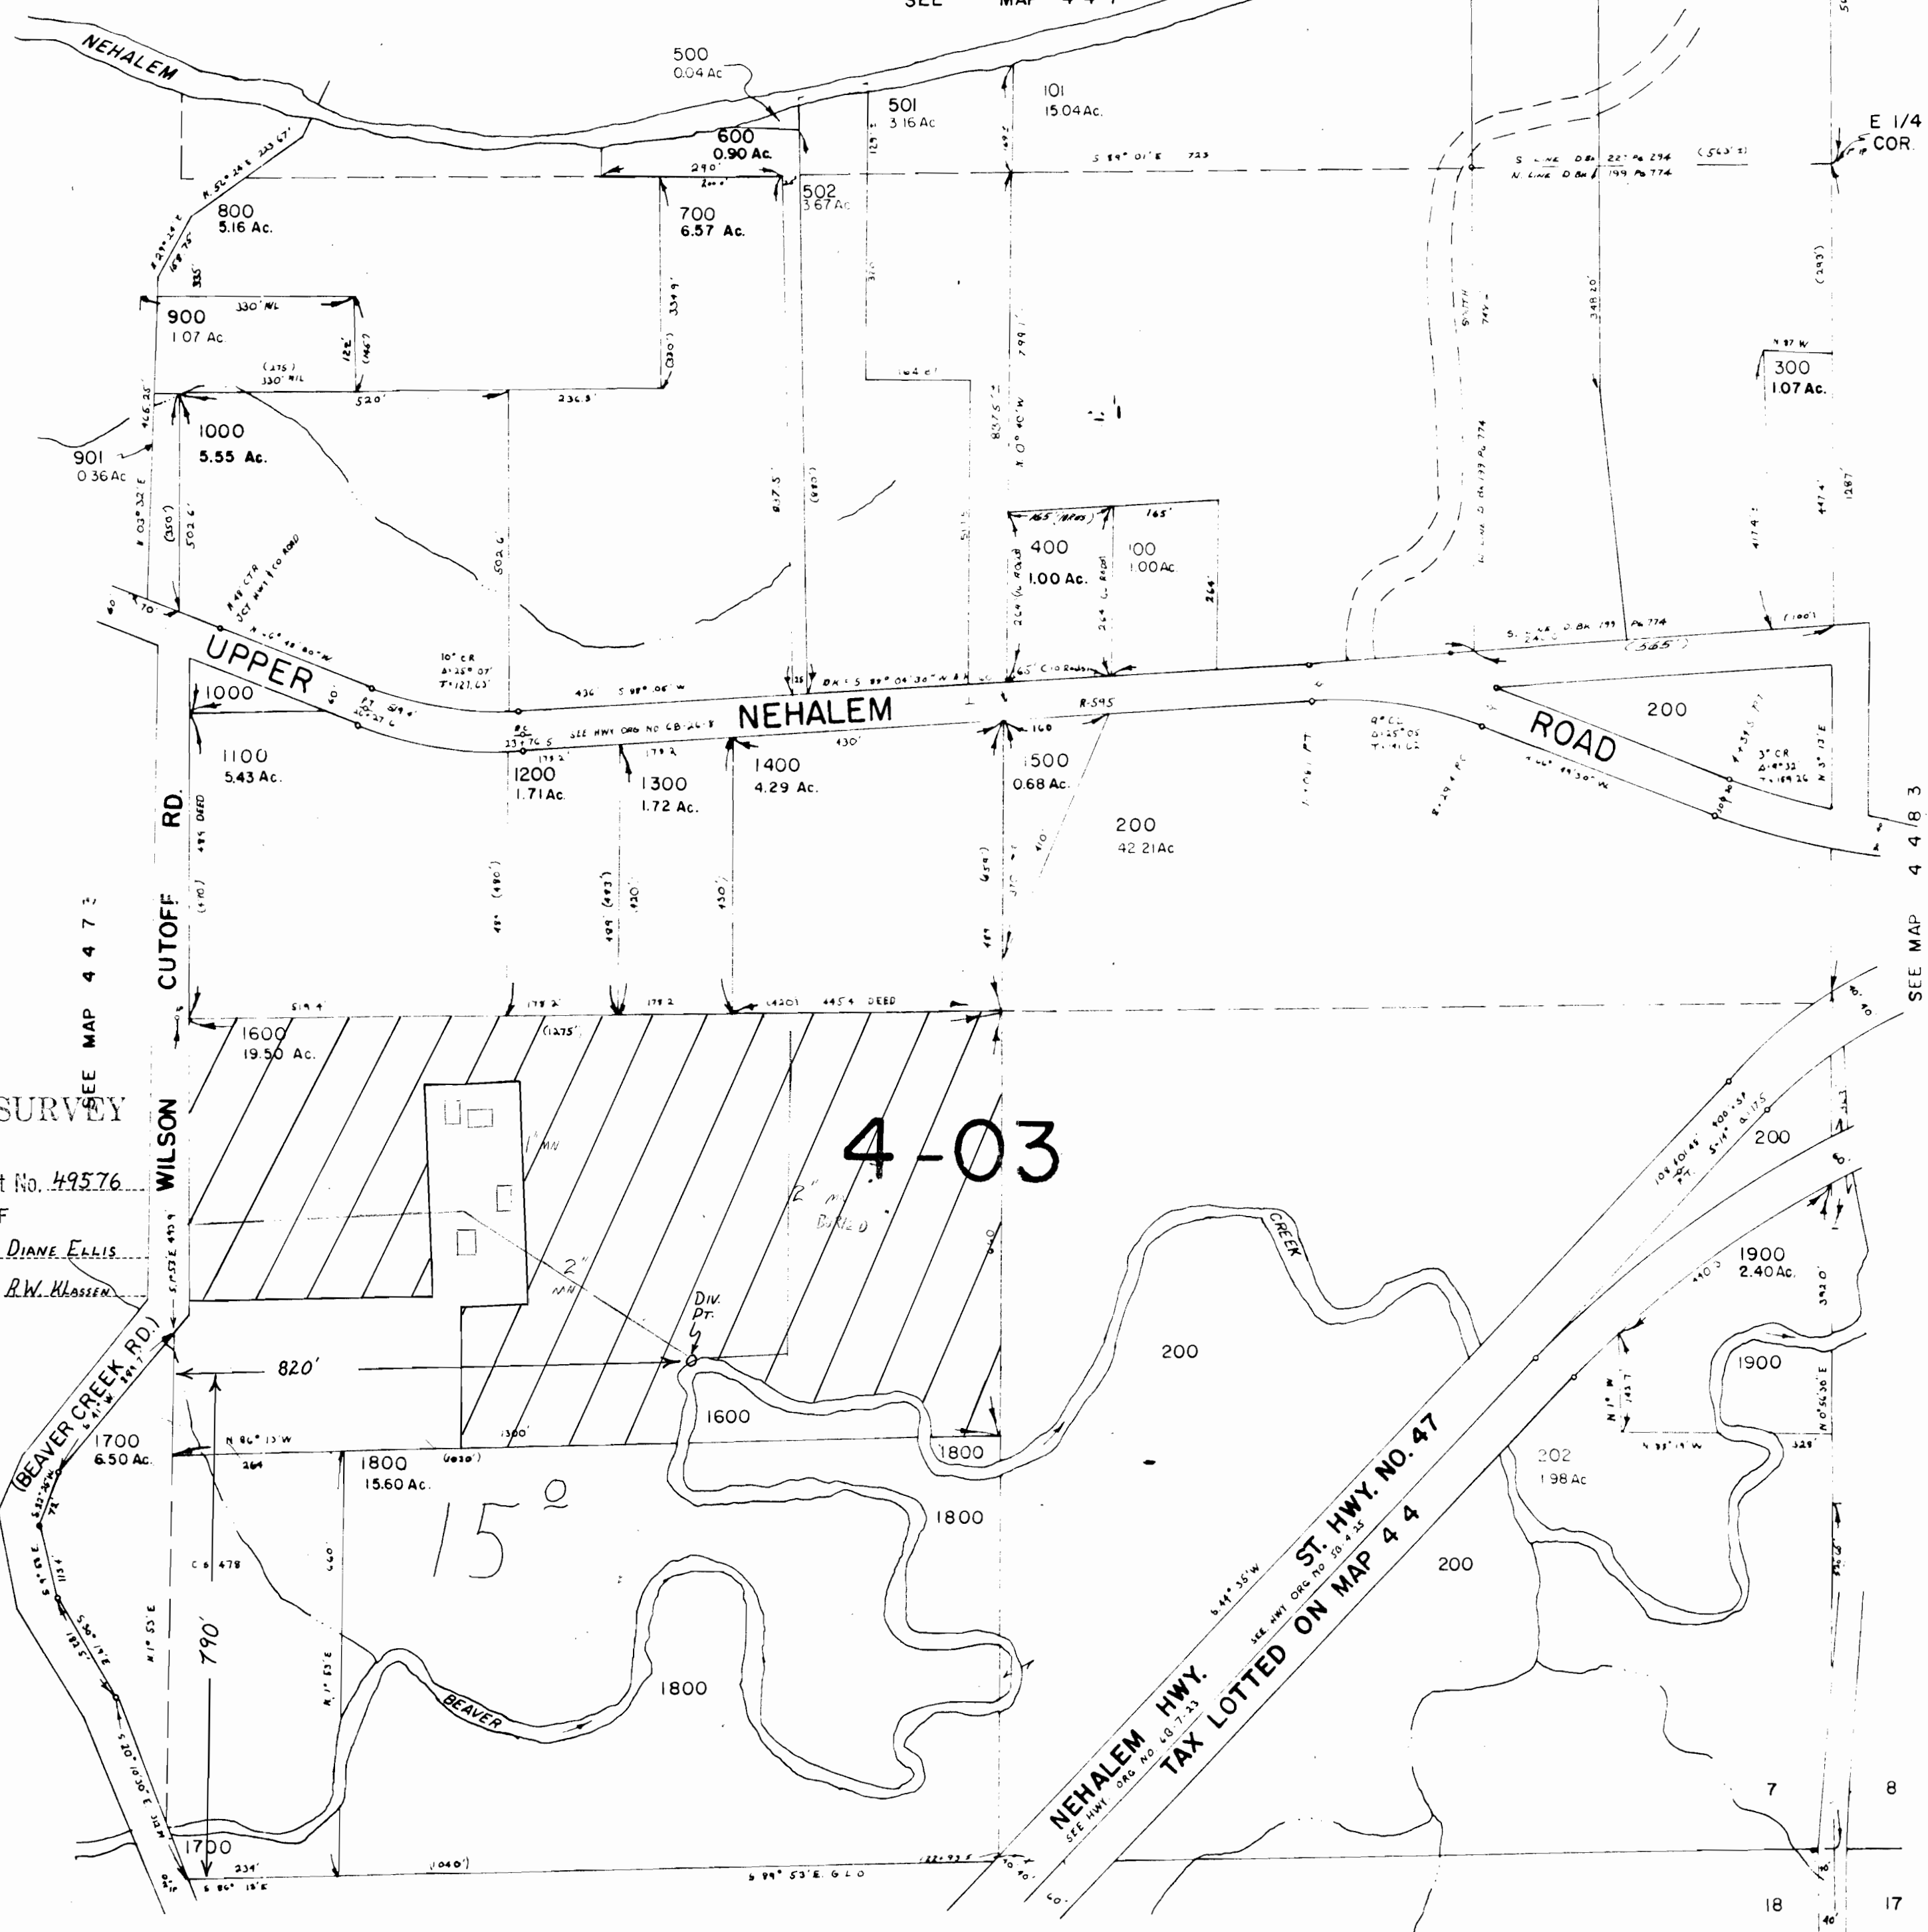

1"=200'

FINAL PROOF SURVEY

UNDER

Application No. 68567 Permit No. 49576

IN NAME OF

STEPHEN EDWARD & KAREN DIANE ELLIS

Surveyed April 17, 1991, by R.W. KLOSSE

4-03

NEHALEM HWY.  
SEE HWY. ORG. NO. 40-7-33  
TAX LOTTED ON MAP 4 4  
ST. HWY. NO. 47  
SEE HWY. ORG. NO. 20-4-35

SEE MAP 4 4 18

4 4 7 4