


T. 33S., R. 18E., W.M.

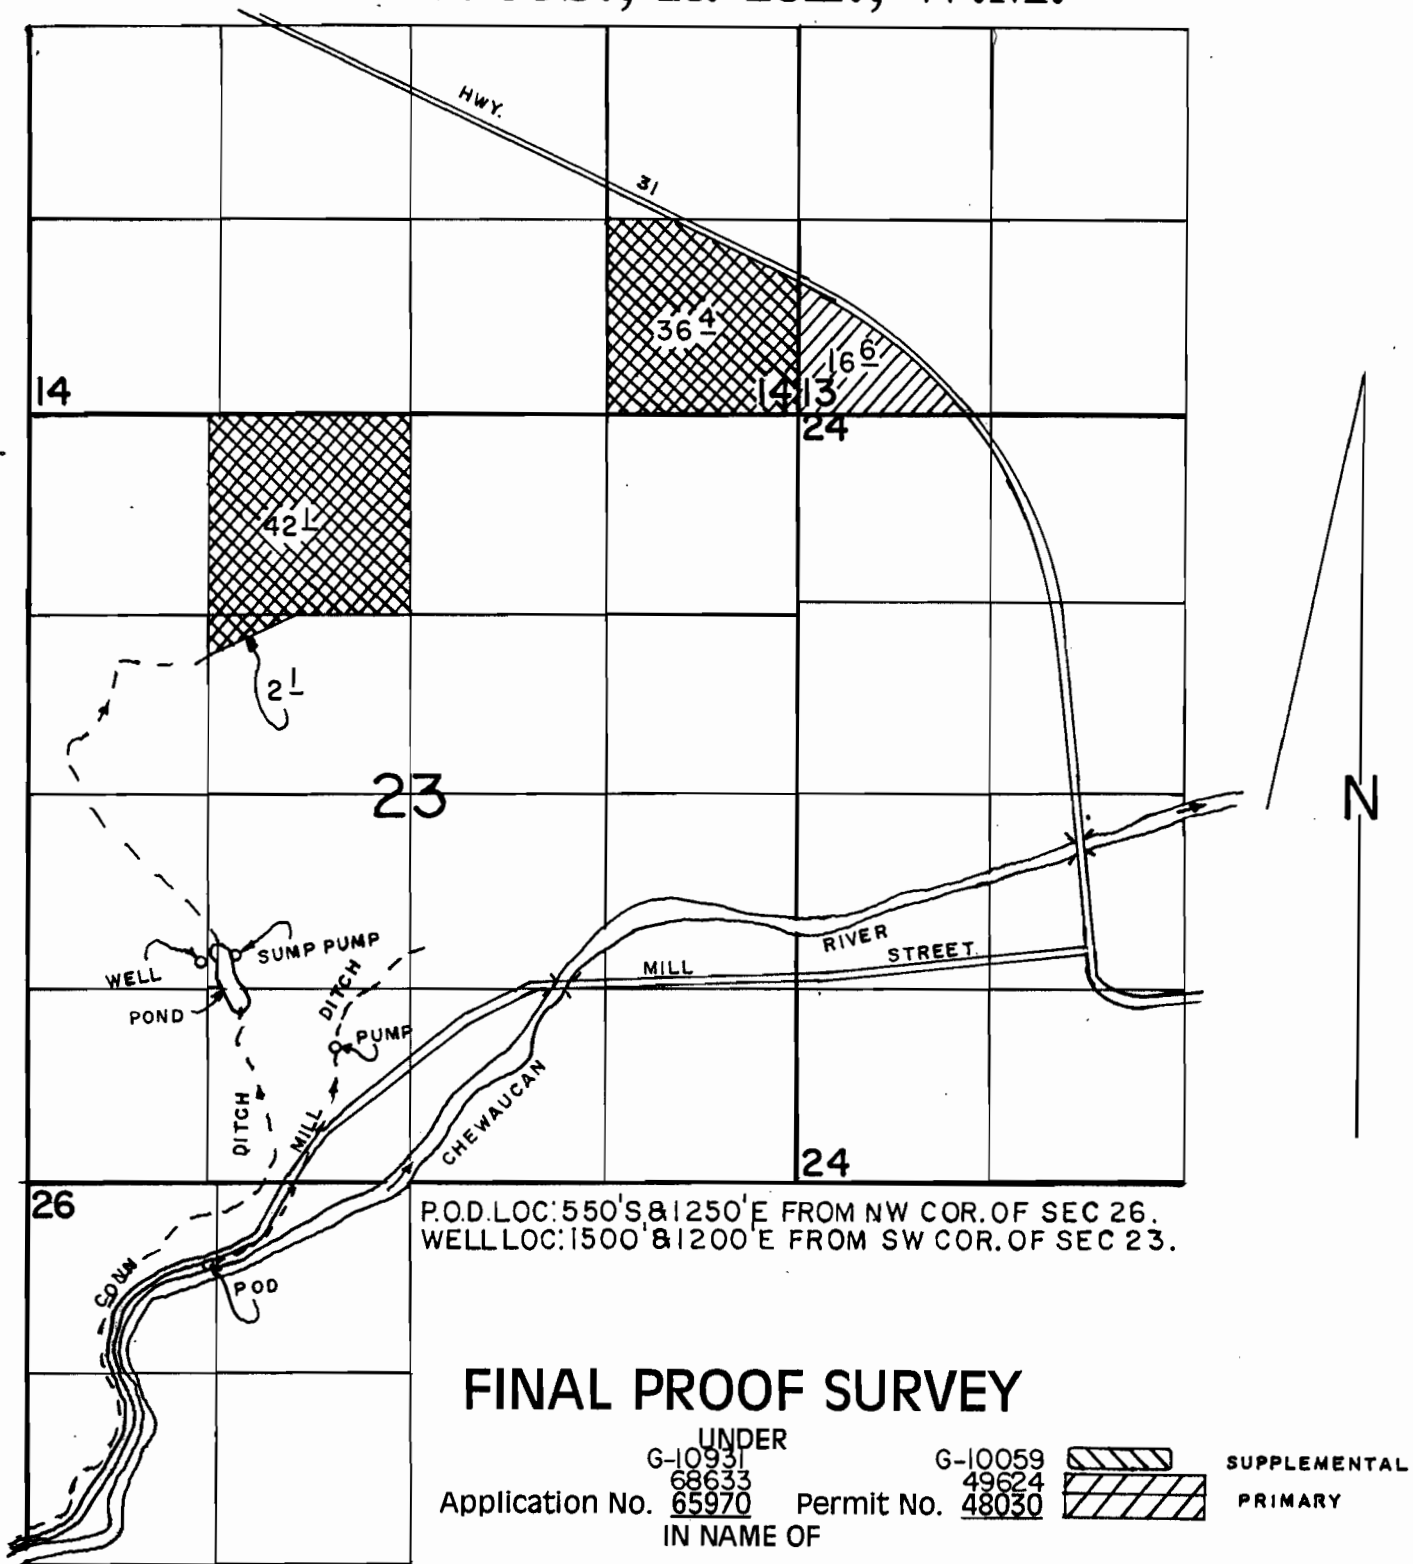

ROSS A. COLAHAN

Surveyed APRIL 12, 1994, by R.M.SUTTERFIELD