


T. 20 S., R. 3 W., W.M.

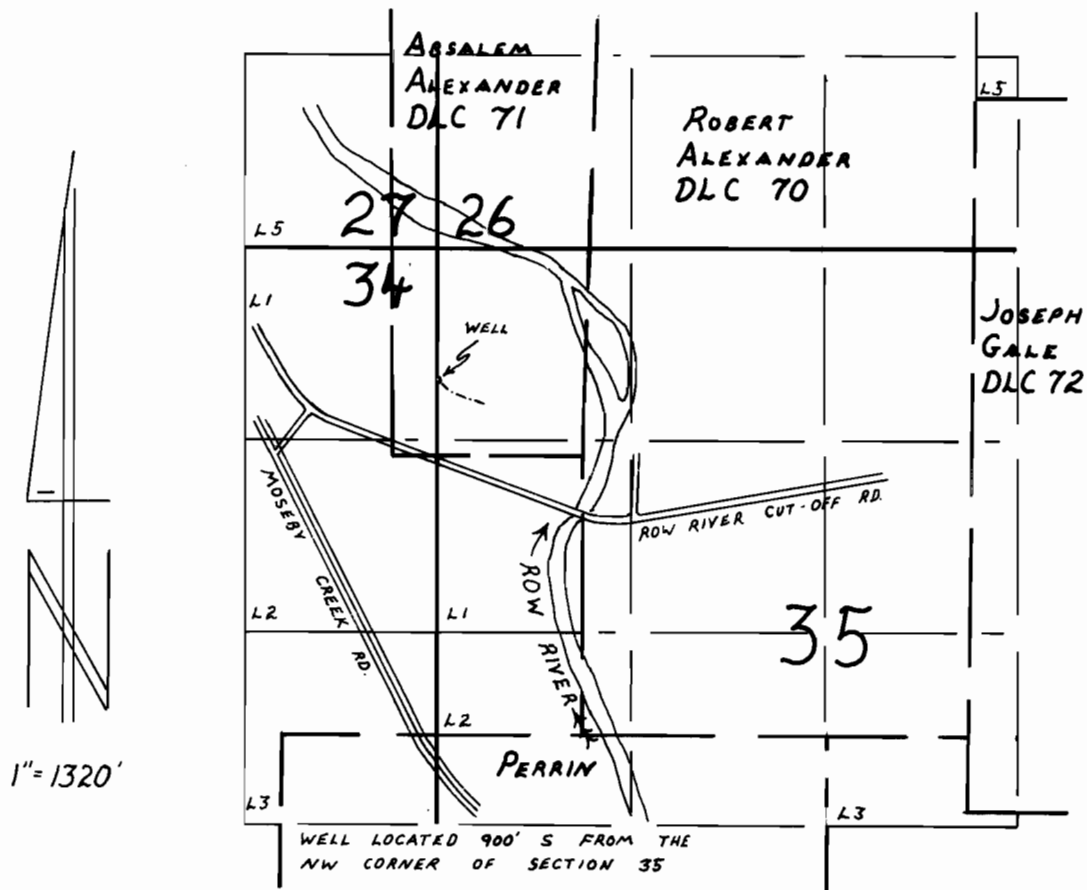

FINAL PROOF SURVEY

UNDER

Application No. G-7813 Permit No. G-7724
IN NAME OF

City of Cottage Grove

Surveyed June 8, 1994, by R.W. Klassen