


FINAL PROOF SURVEY
UNDER
Application No. G-8778 Permit No. G-8278
IN NAME OF
WILSON RIVER WATER DISTRICT
Surveyed JULY 21 19 93, by R.W. Keassey

PRODUCED BY THE UNITED STATES GEOLOGICAL SURVEY
CONTROL BY USGS, NOS/NOAA, USCE
COMPILED FROM AERIAL PHOTOGRAPHS TAKEN 1980
FIELD CHECKED 1982 MAP EDITED 1985
PROJECTION LAMBERT CONFORMAL CONIC
GRID: 1000-METER UNIVERSAL TRANSVERSE MERCATOR
1000-FOOT STATE GRID TICS OREGON, NORTH ZONE
UTM GRID DECLINATION 035 WEST
1980 MAGNETIC NORTH DECLINATION 20 EAST
VERTICAL DATUM NATIONAL GEODETIC VERTICAL DATUM OF 1929
HORIZONTAL DATUM 1927 NORTH AMERICAN DATUM
To place on the predicted North American Datum of 1983,
move the projection lines as shown by dashed corner ticks
(24 meters north / 97 meters east)
There may be private inholdings within the boundaries of any
Federal and State Reservations shown on this map
No distinction made between houses, barns, and other buildings
Gray tint indicates area in which selected buildings are shown

PROVISIONAL MAP
Produced from original
manuscript drawings. Informa-
tion shown as of date of
photography.

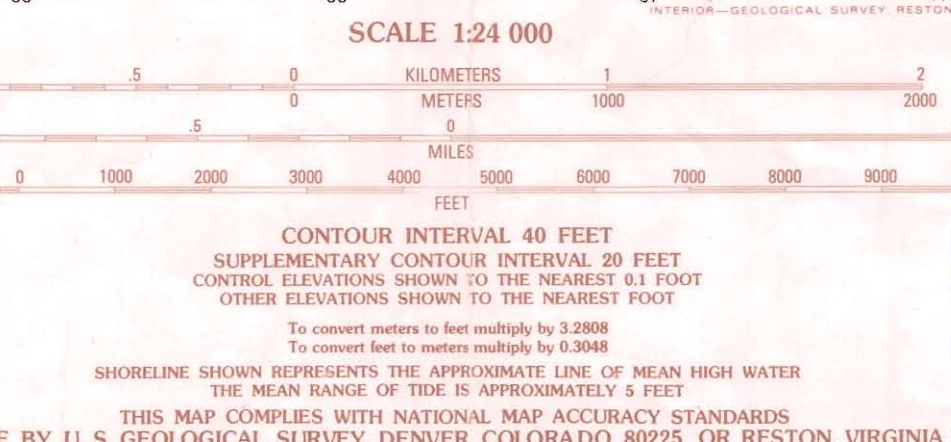

ROAD LEGEND

Improved Road.....
Unimproved Road.....
Trail.....
Interstate Route U.S. Route State Route

TILLAMOOK, OREG.
PROVISIONAL EDITION 1985

45123-D7-TF-024