
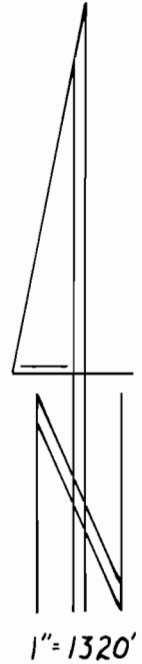


T. 16 S., R. 11 W., W.M.

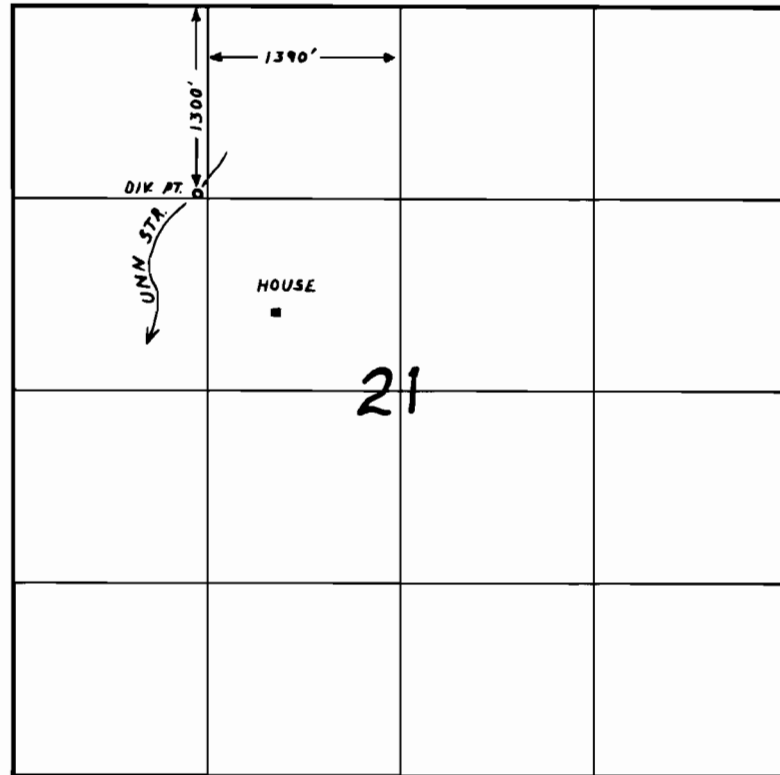

FINAL PROOF SURVEY

UNDER

Application No. 60903 Permit No. 46581
IN NAME OF

PHILLIP WEATHERSBY COLE

Surveyed MAY 20, 1992, by R.W. Klassen