


T. 7 S., R. 10 W., W.M.

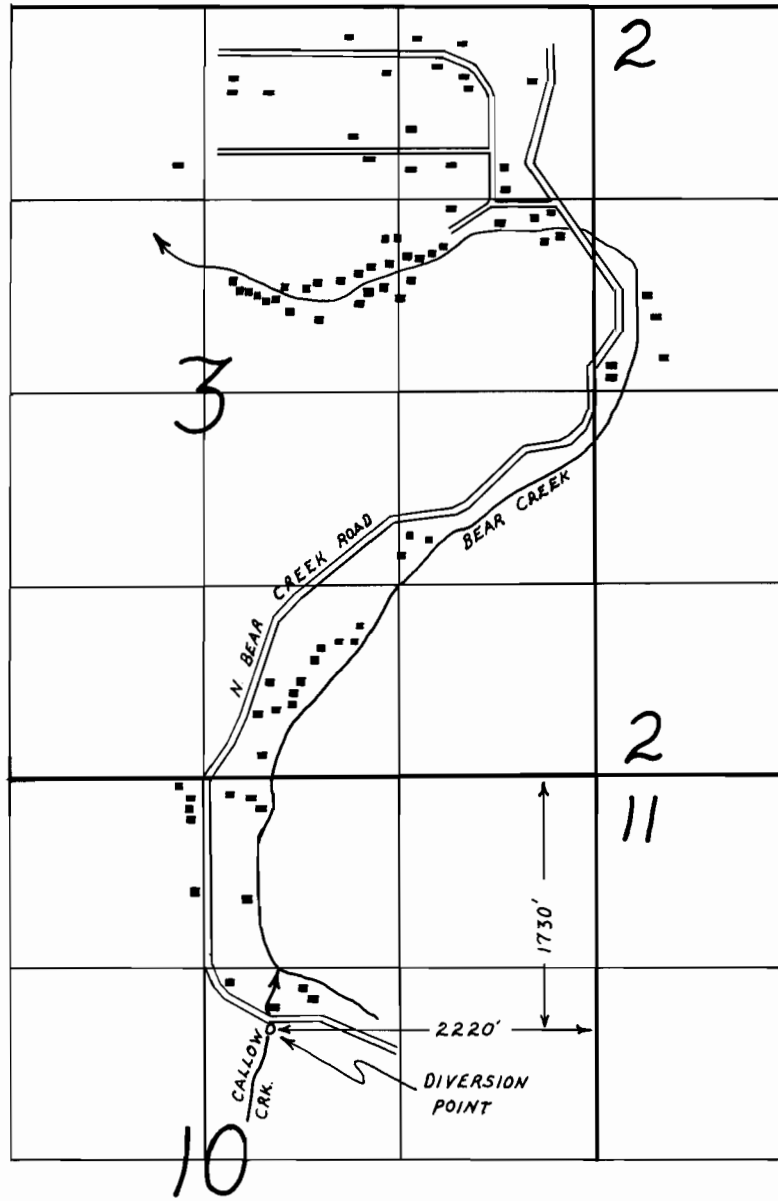

FINAL PROOF SURVEY

UNDER

Application No. 48999 Permit No. 36681
IN NAME OF

Rose Lodge Water Company

Surveyed May 11, 1994, by R.W. Klassen