


SECTION

TOWNSHIP 14S, RANGE 16E, W. M.

North

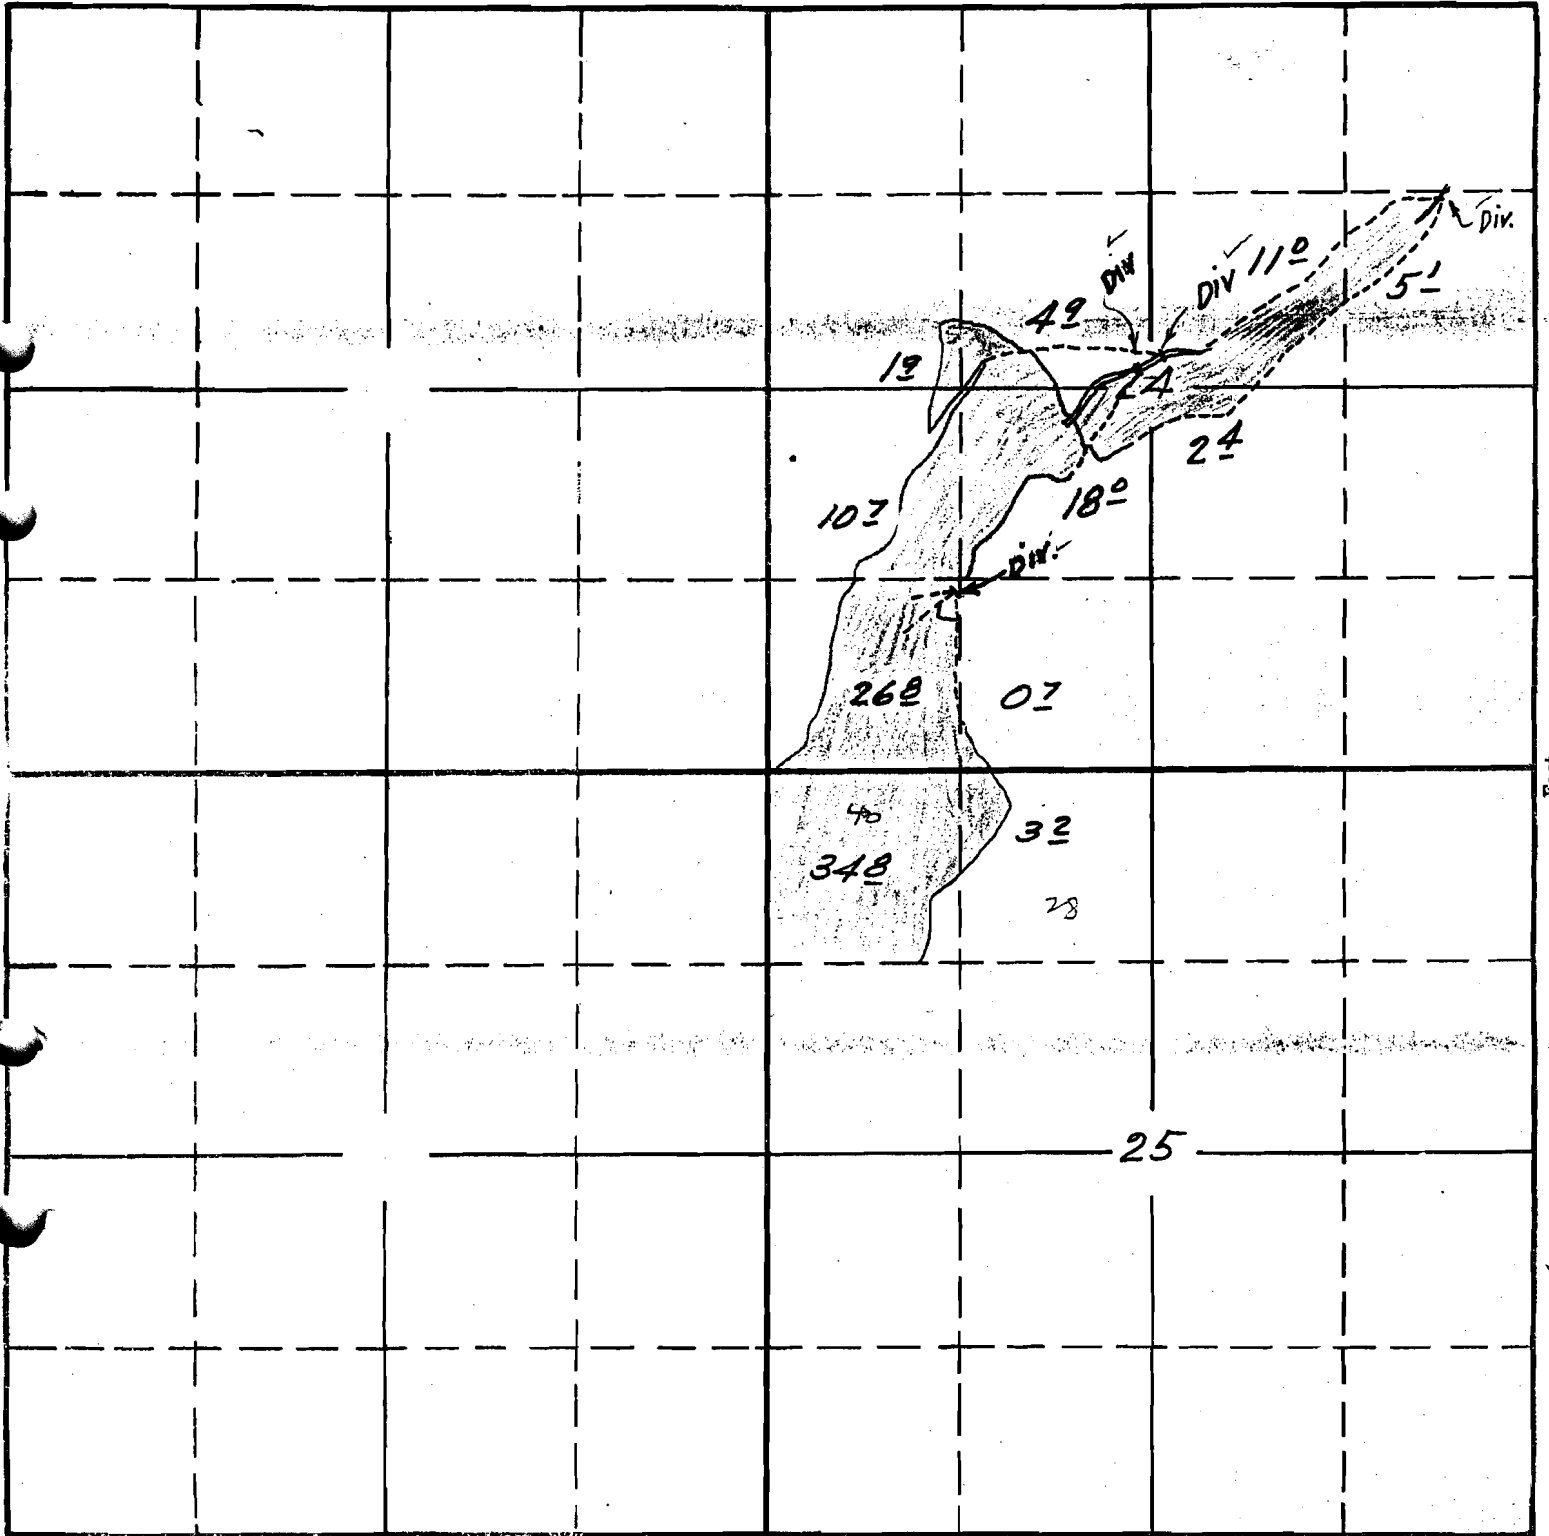

Surveyed Sept 18 1940 E.A.B.

South

APPLICATION No. 15721  
PERMIT No. 11581

C-13456

11581