


T.14S.R.16E.W.M.

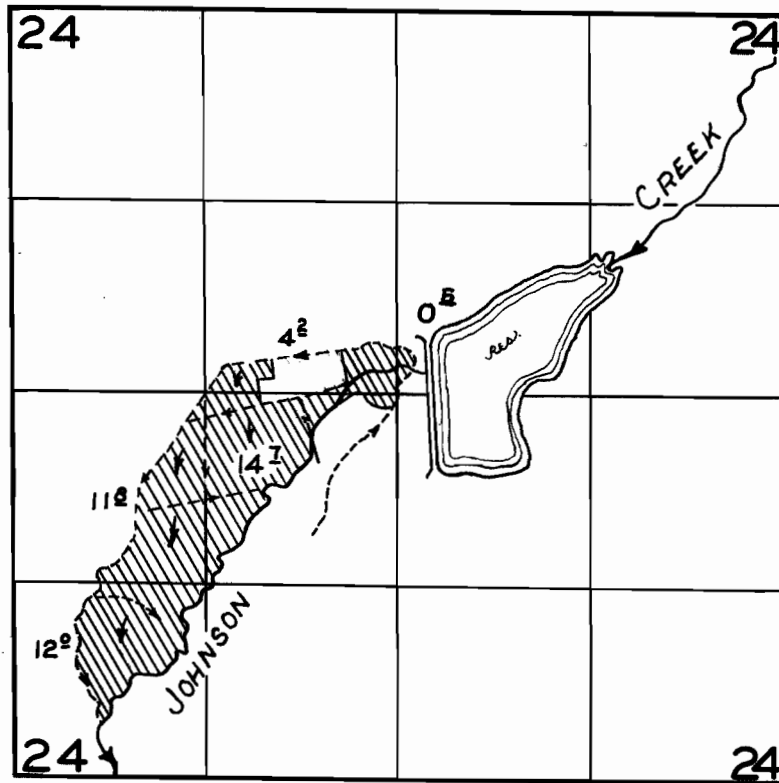

FINAL PROOF SURVEY
UNDER

Application No. ^{R-25574} ~~26457~~ Permit No. ^{R-1303} ~~21003~~
IN NAME OF

..... CLAUDE HUDSPETH

Surveyed Oct. 7 19.60, by [Signature]