


T.14S.R.15E.W.M.

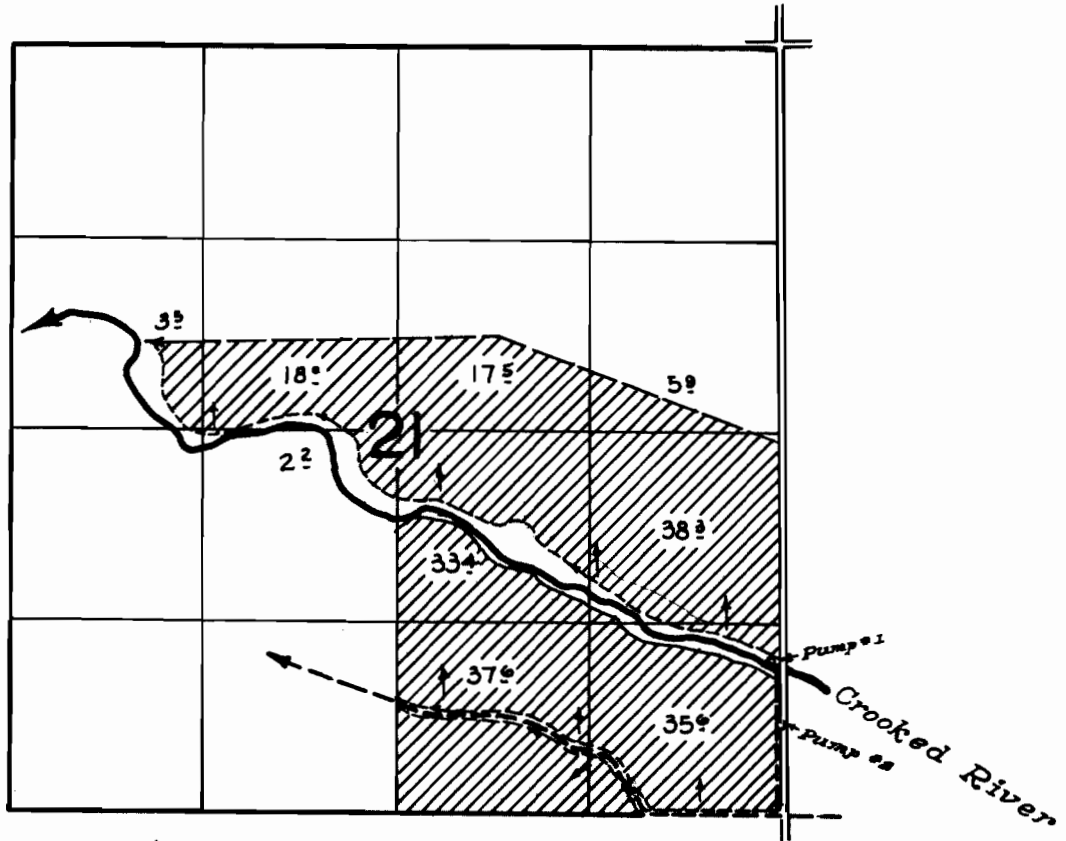

FINAL PROOF SURVEY
UNDER

Application No. 29846... Permit No. 23259....
IN NAME OF

Hudspeth Land & Livestock Co.

Surveyed Sept. 27 1960, by *Apperson*