


T. 14 S. R. 15 E. W.M.

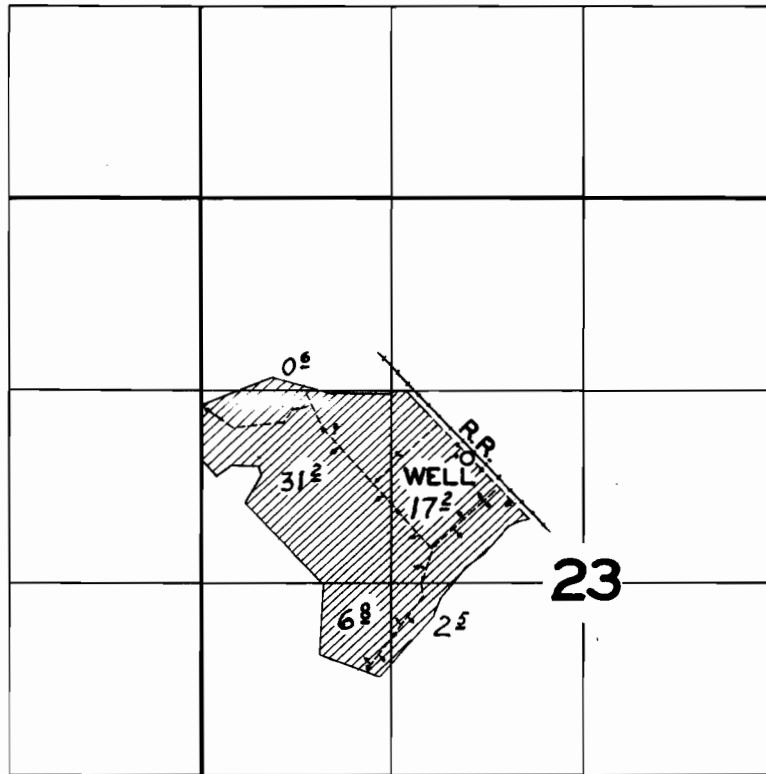

FINAL PROOF SURVEY  
UNDER

Application No. U-344 Permit No. U-319  
IN NAME OF

CLAUDE F. WILLIAMS

Surveyed JULY 31 1957, by C.O. BARTELS