


OCHOCO IRRIGATION DISTRICT


T. 14S., R. 16E., W.M., Section 33

SCALE: 1" = 400'

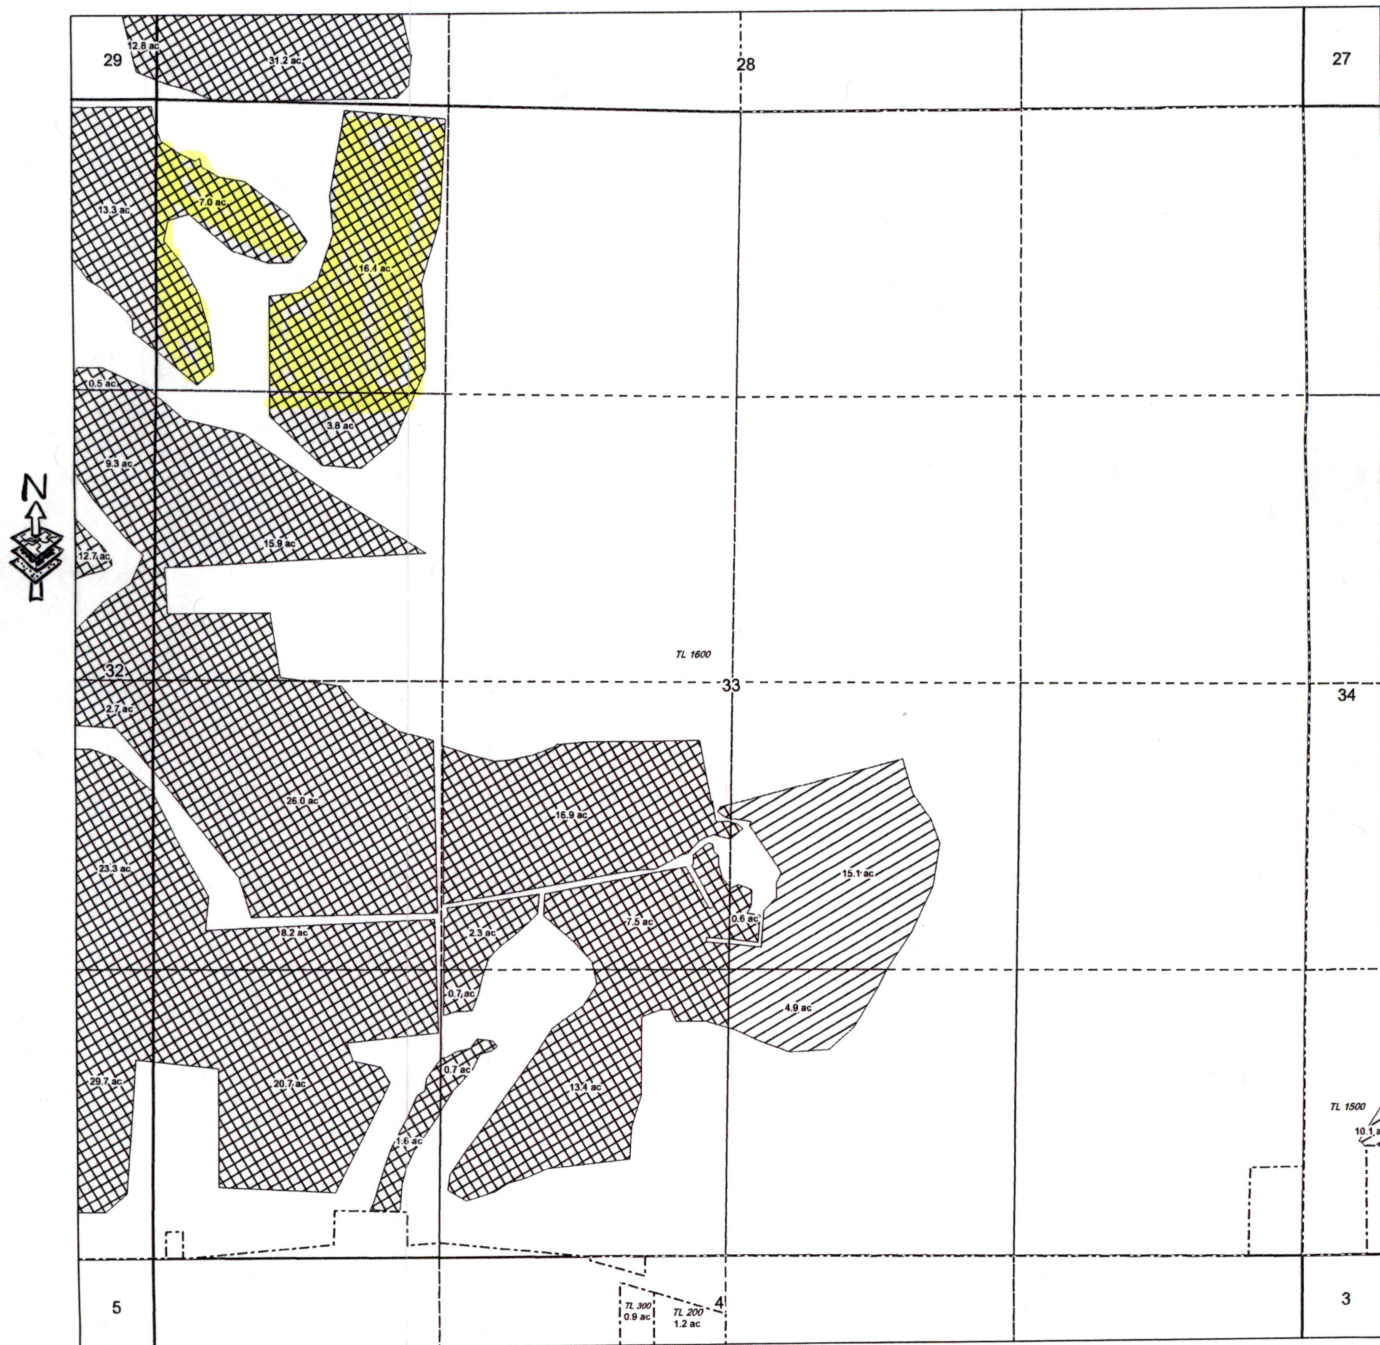

3111


Cert. 82267 & Cert 82268

 

OCHOCO IRRIGATION DISTRICT

T. 14S., R. 16E., W.M., Section 28

SCALE: 1" = 400'

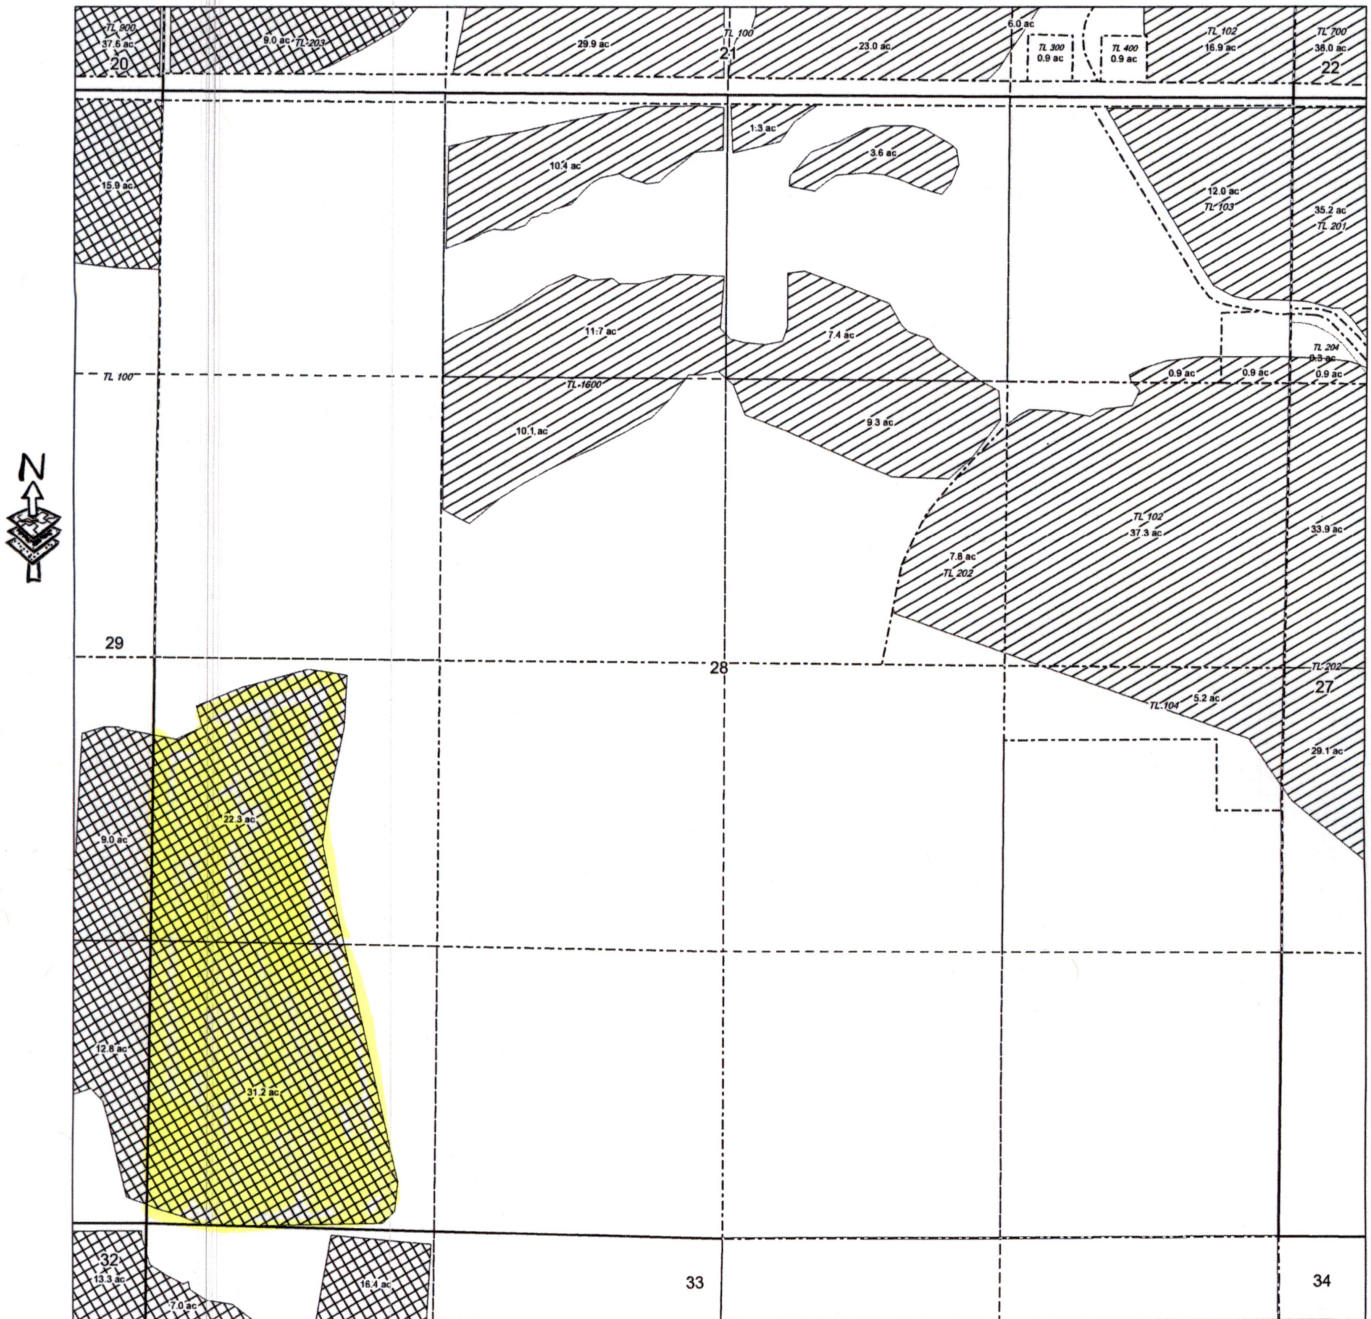


3111

C. 82267 + 82268

OCHOCO IRRIGATION DISTRICT

T. 14S., R. 16E., W.M., Section 29

SCALE: 1" = 400'

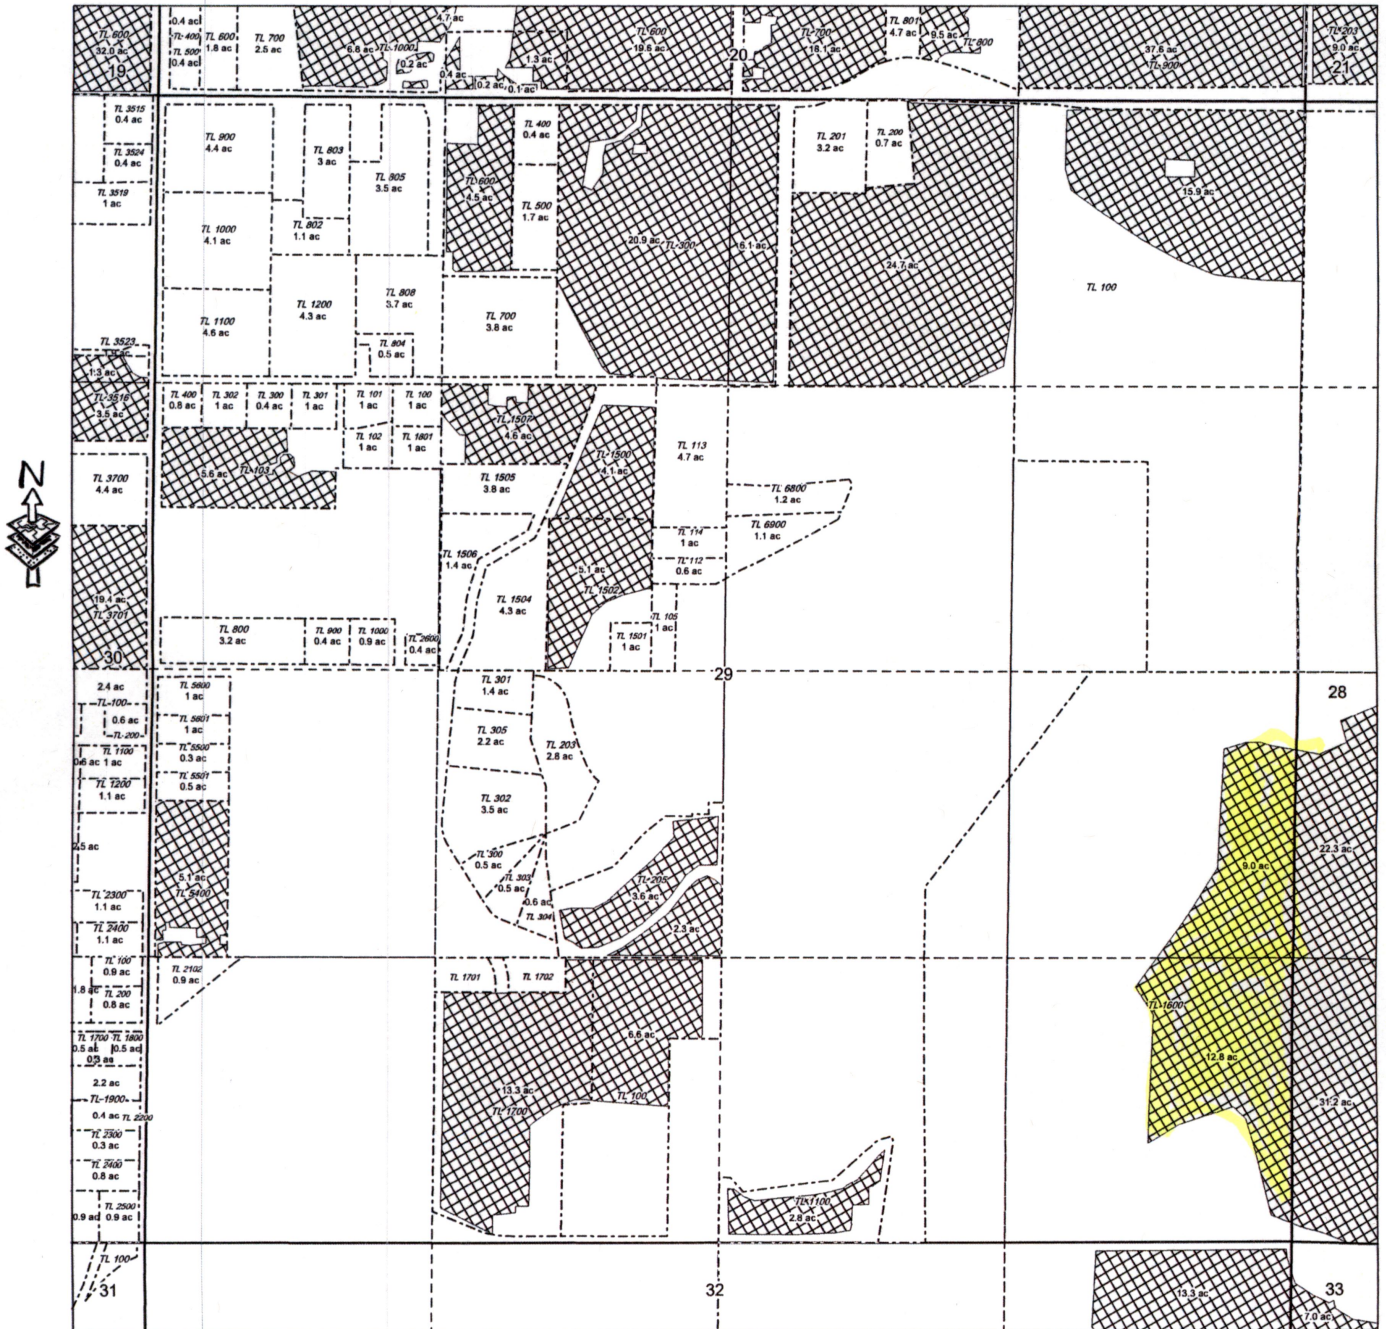

3111




82267 & 82268


OCHOCO IRRIGATION DISTRICT

T. 14S., R. 16E., W.M., Section 32

SCALE: 1" = 400'

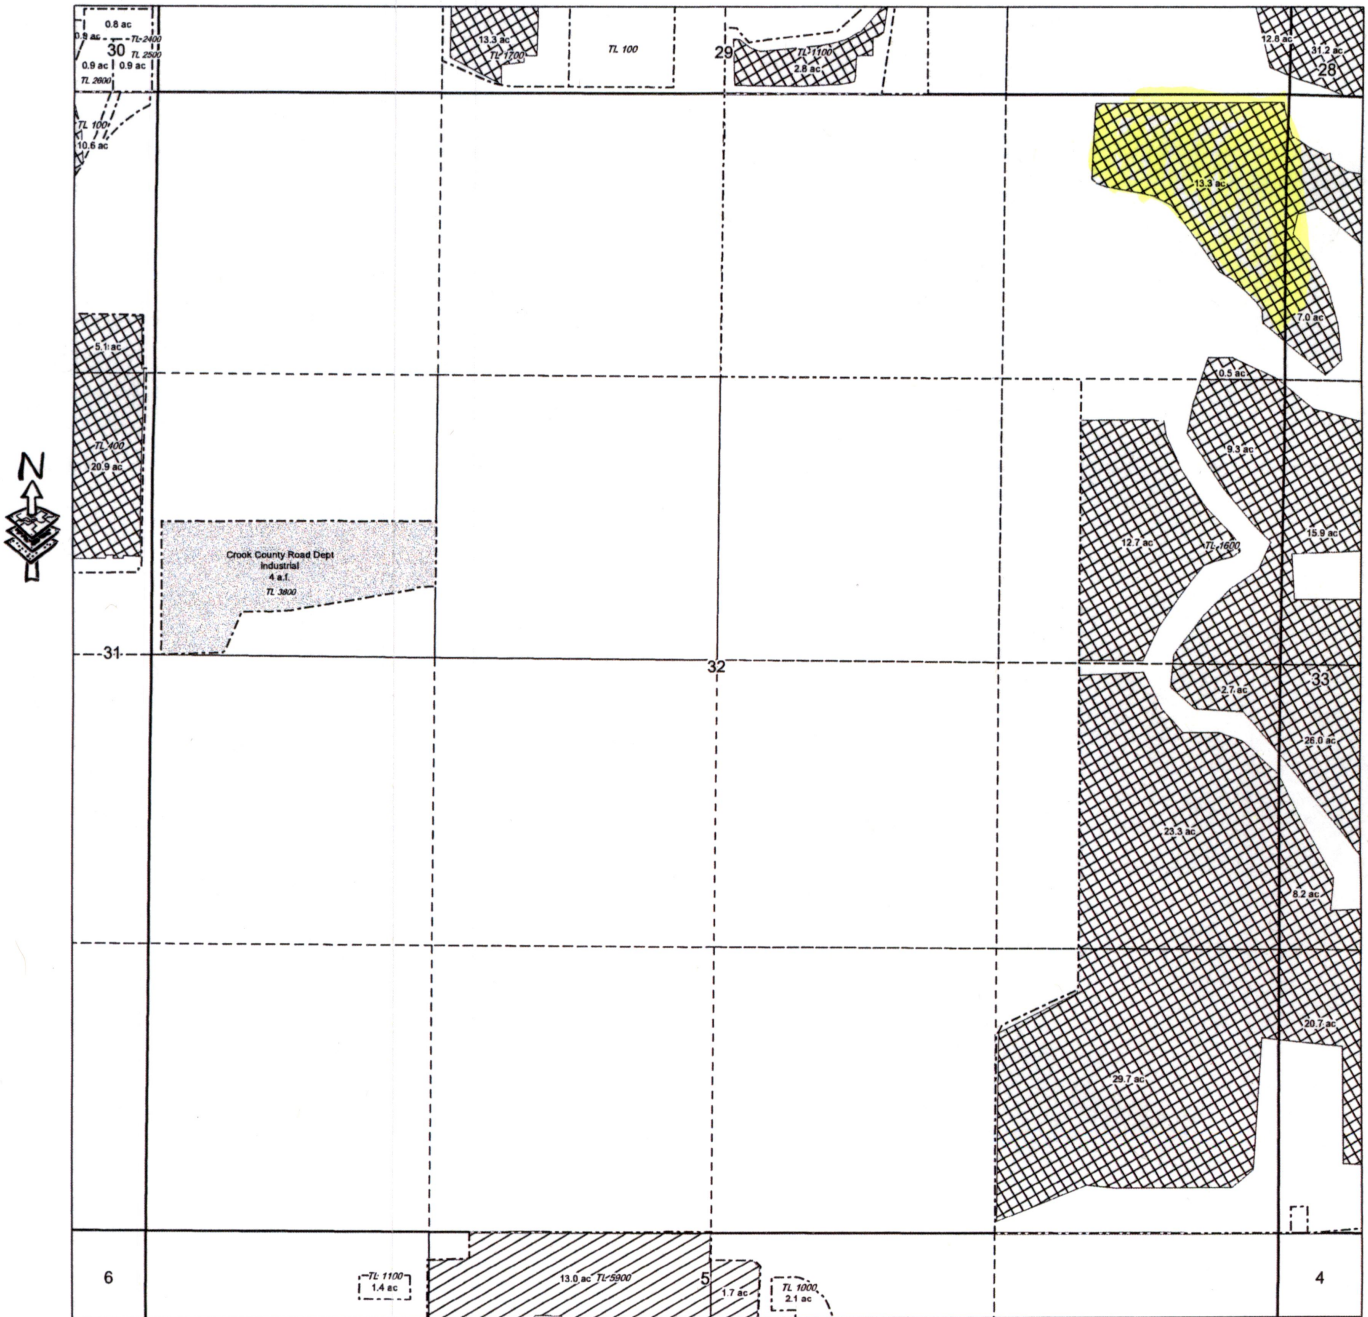

3111

 

82267 + 82268