


T.15S. R.16E.W.M.

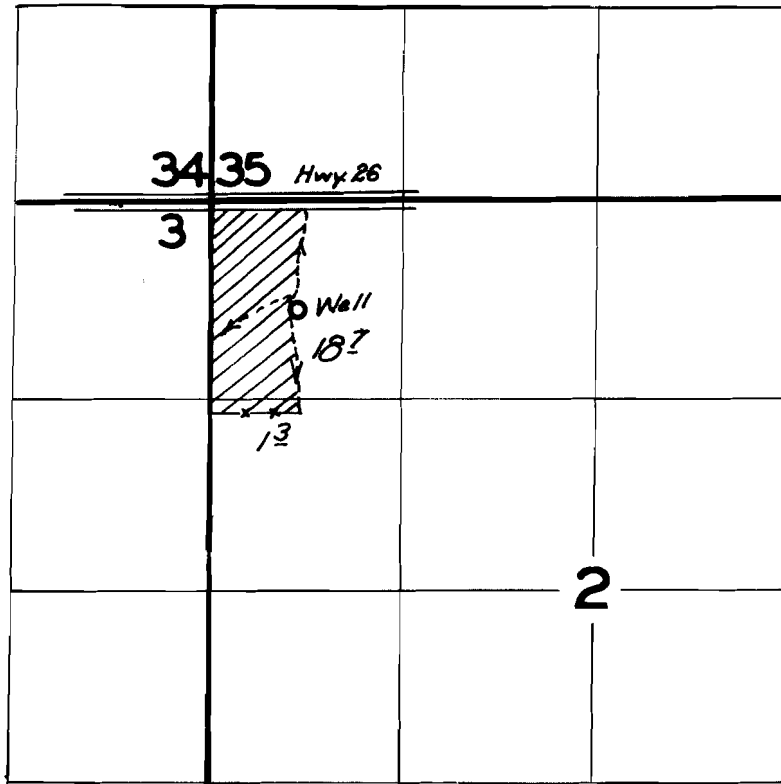

FINAL PROOF SURVEY
UNDER

Application No. *G-1596*... Permit No. *G-1465*...
IN NAME OF

Pilot Butte Herford Ranch, Inc

Surveyed *Nov. 1*... 1962, by *Carl R. Baker*.