


T.14S. R.16E.W.M.

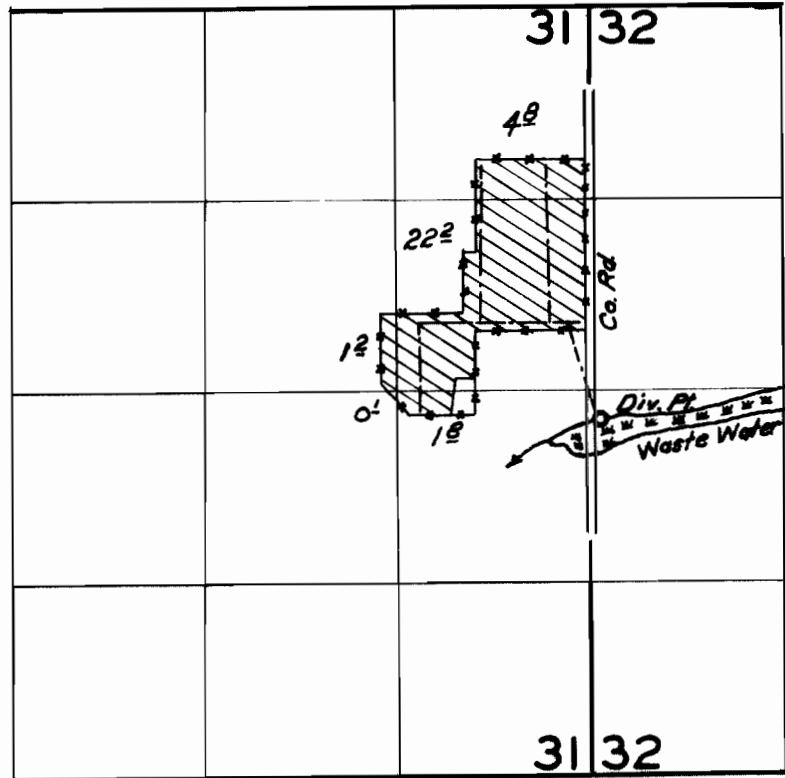

**FINAL PROOF SURVEY**  
UNDER

Application No. 30570... Permit No. 24083..  
IN NAME OF

*Crook County Cemetery District*

Surveyed 29 Oct. 1962, by Carl R. Baker...