
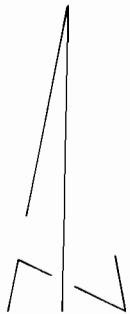


T. 11S., R. 40E., W.M.

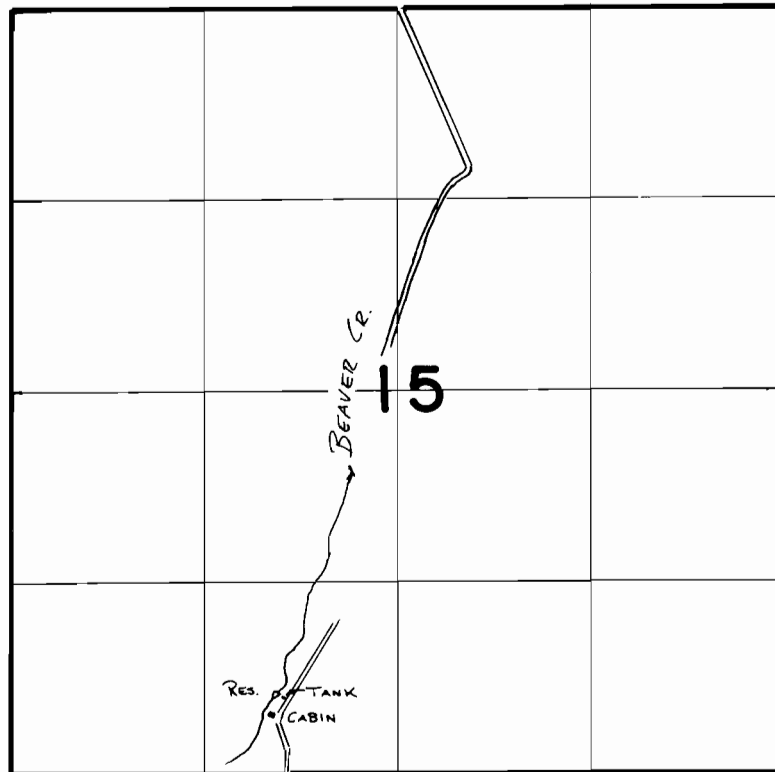

SCALE 1" = 1320'

FINAL PROOF SURVEY
UNDER

TRANSFER 3627
IN NAME OF

OLEN D. & FLORENCE A. RAGSDALE

Surveyed 4-12..... 1990., by V.L. Church.....