


T. 37S., R. 21E., W.M.

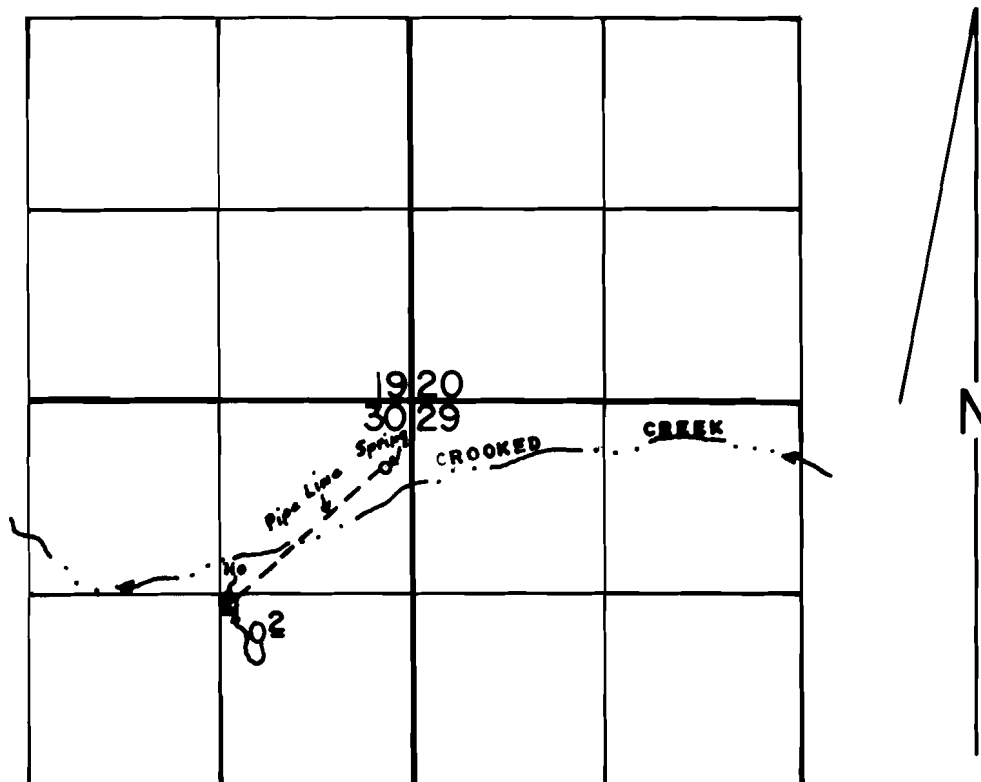

SPRING LOC: 450'S & 150' W FROM NE COR. OF SEC 30.

SCALE: 1" = 1320'

FINAL PROOF SURVEY

UNDER

**Application No. 64478 Permit No. 47227
IN NAME OF**

DAVID O'CONNOR

Surveyed MAY 11, 1994, by R.M.SUTTERFIELD