


T30S,R16,17E,WM.

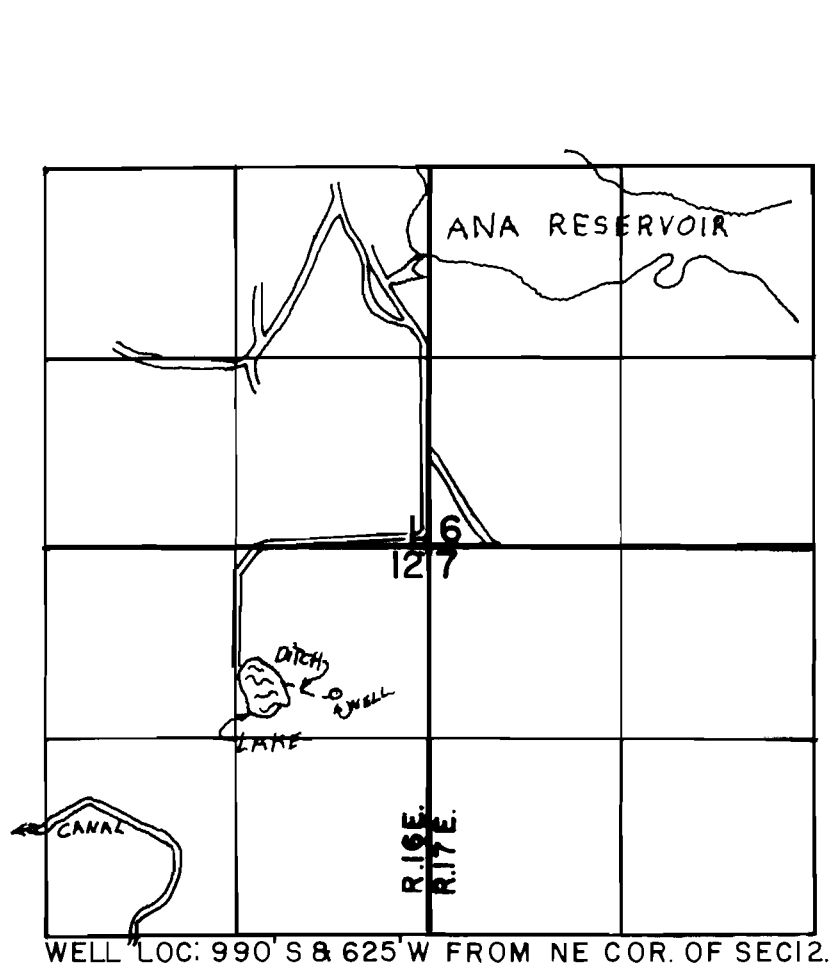

FINAL PROOF SURVEY
UNDER

Application No. G-10830 Permit No. G-10091...
IN NAME OF

OREGON DEPT. OF FISH & WILDLIFE

Surveyed JULY 10 1996, by R.M. SUTTERFIELD