


# T. 4 N., R. 27 E., W.M.

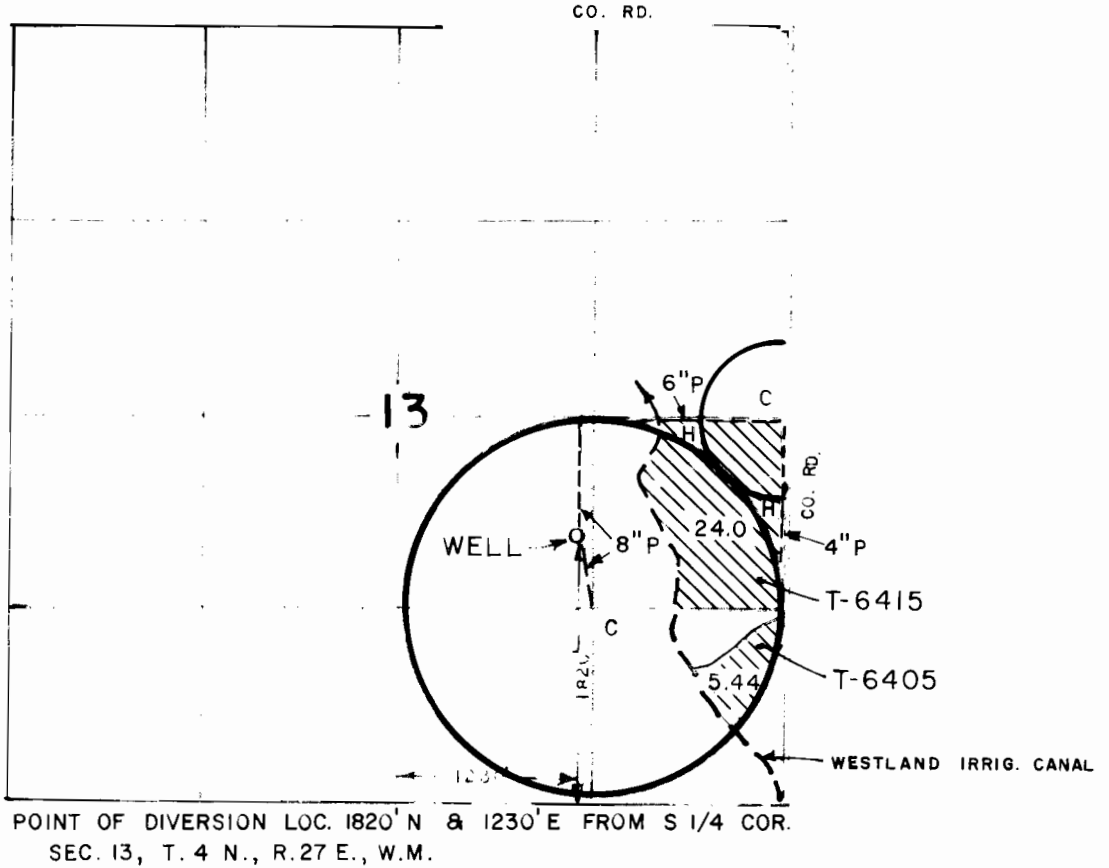


SCALE 1" = 1320'



The preparation of this map was for the purpose of identifying the location of water right only, and has no intent to provide dimensions or location of property ownership lines.

- C = CENTER PIVOT
- P = BURIED PIPELINE
- H = HANDLINES

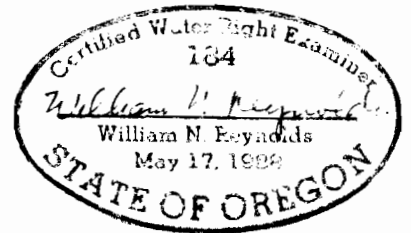

## FINAL PROOF SURVEY

UNDER  
 Application No. **T-6405** Permit No. **G-2620, G-4039**  
**T-6415** **G-3966**  
 IN NAME OF

**MALCOLM SKINNER**

Surveyed July 11, 1991, by W. N. Reynolds