T.14S., R.2W., W.M.

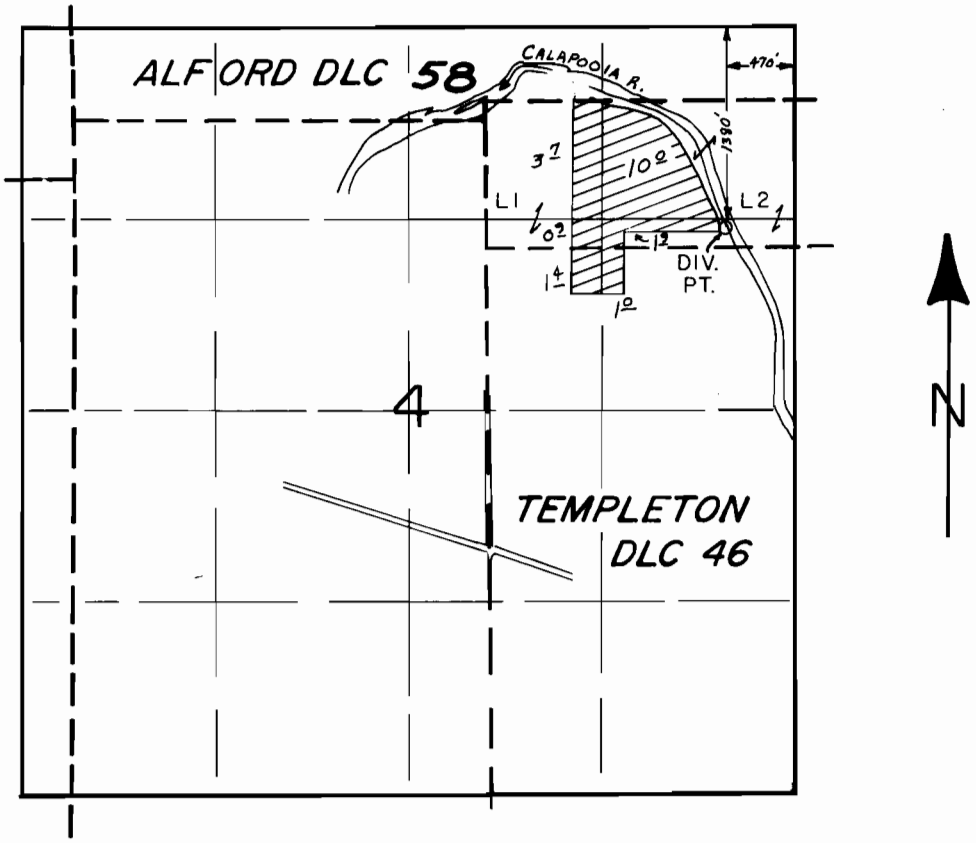

SCALE: 1" = 1320'

FINAL PROOF SURVEY
UNDER

Application No. 55479 Permit No. 41869
IN NAME OF
MR. & MRS. ALBERT F. CIERI

Surveyed JUNE 12 1984, by L. M. TOLL

JNG 3/6/06
DFM IJJ 122 MCB.