


T. 9S., R. 2E., W. M.

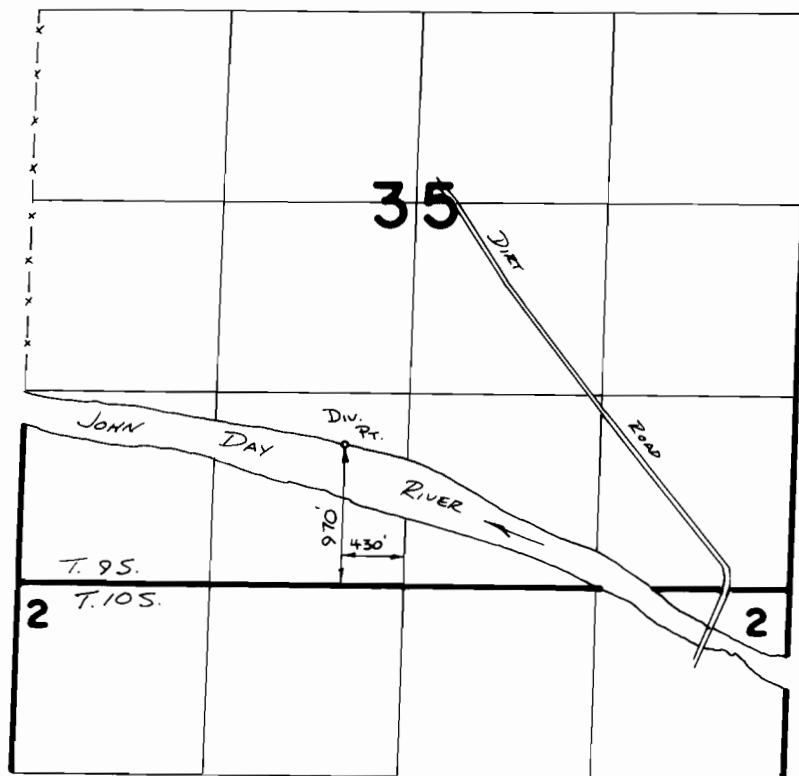

SCALE 1" = 1320'

FINAL PROOF SURVEY
UNDER

TRANSFER 5409
IN NAME OF

A. MATTHEW WILLIAMS

Surveyed 4-21..... 1986, by V.L. Church