


T. 30 S., R. 17 E., W.M.

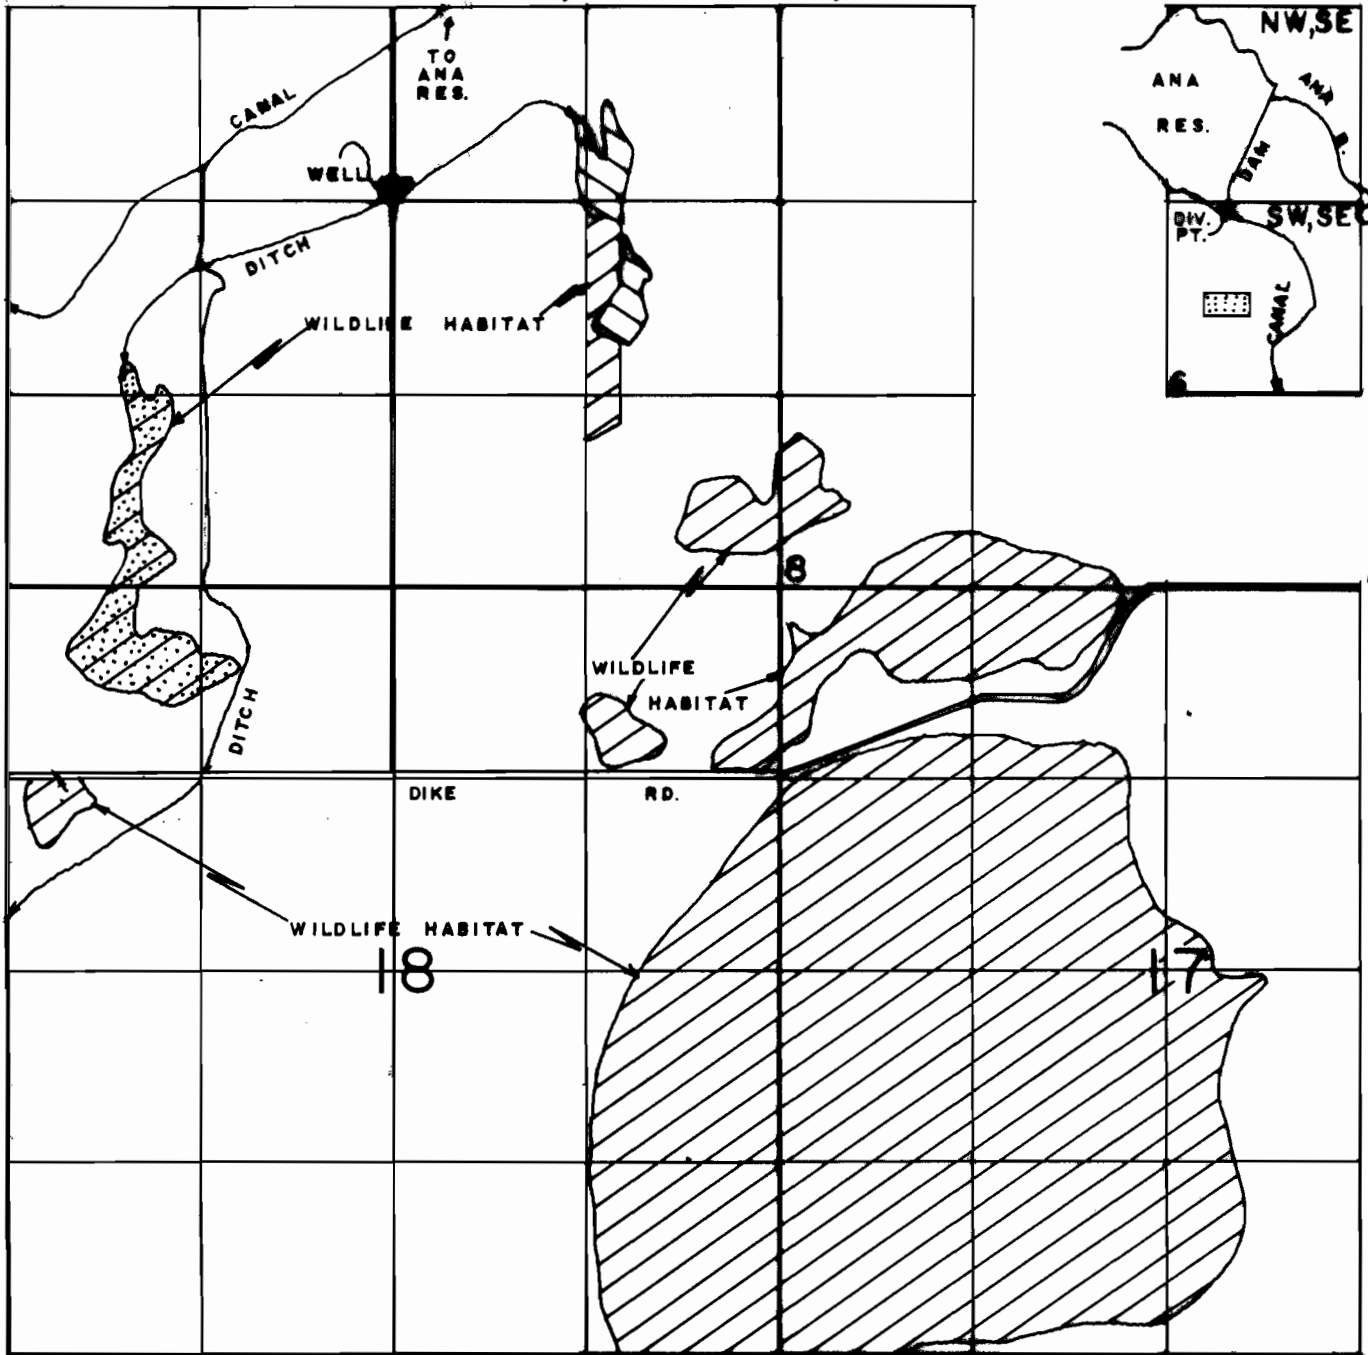

FINAL PROOF SURVEY

UNDER
 G-1558 G-10687
 G-10414 G-10433
 Application No. 68294 Permit No. 49352
 IN NAME OF

FEB - 8 1994

WATER RESOURCES DEP
SALEM, OREGON

OREGON DEPARTMENT OF FISH AND WILDLIFE

Surveyed OCT 19, 1993, by R.M.SUTTERFIELD

WELL LOC: 30' N & 50' W FROM CEN COR. OF SEC 7.  
 DIV. PT. LOC: 1260' N & 2240' W FROM SE COR. OF SEC 6. 