


T. 30 S., R. 17 E., W.M.

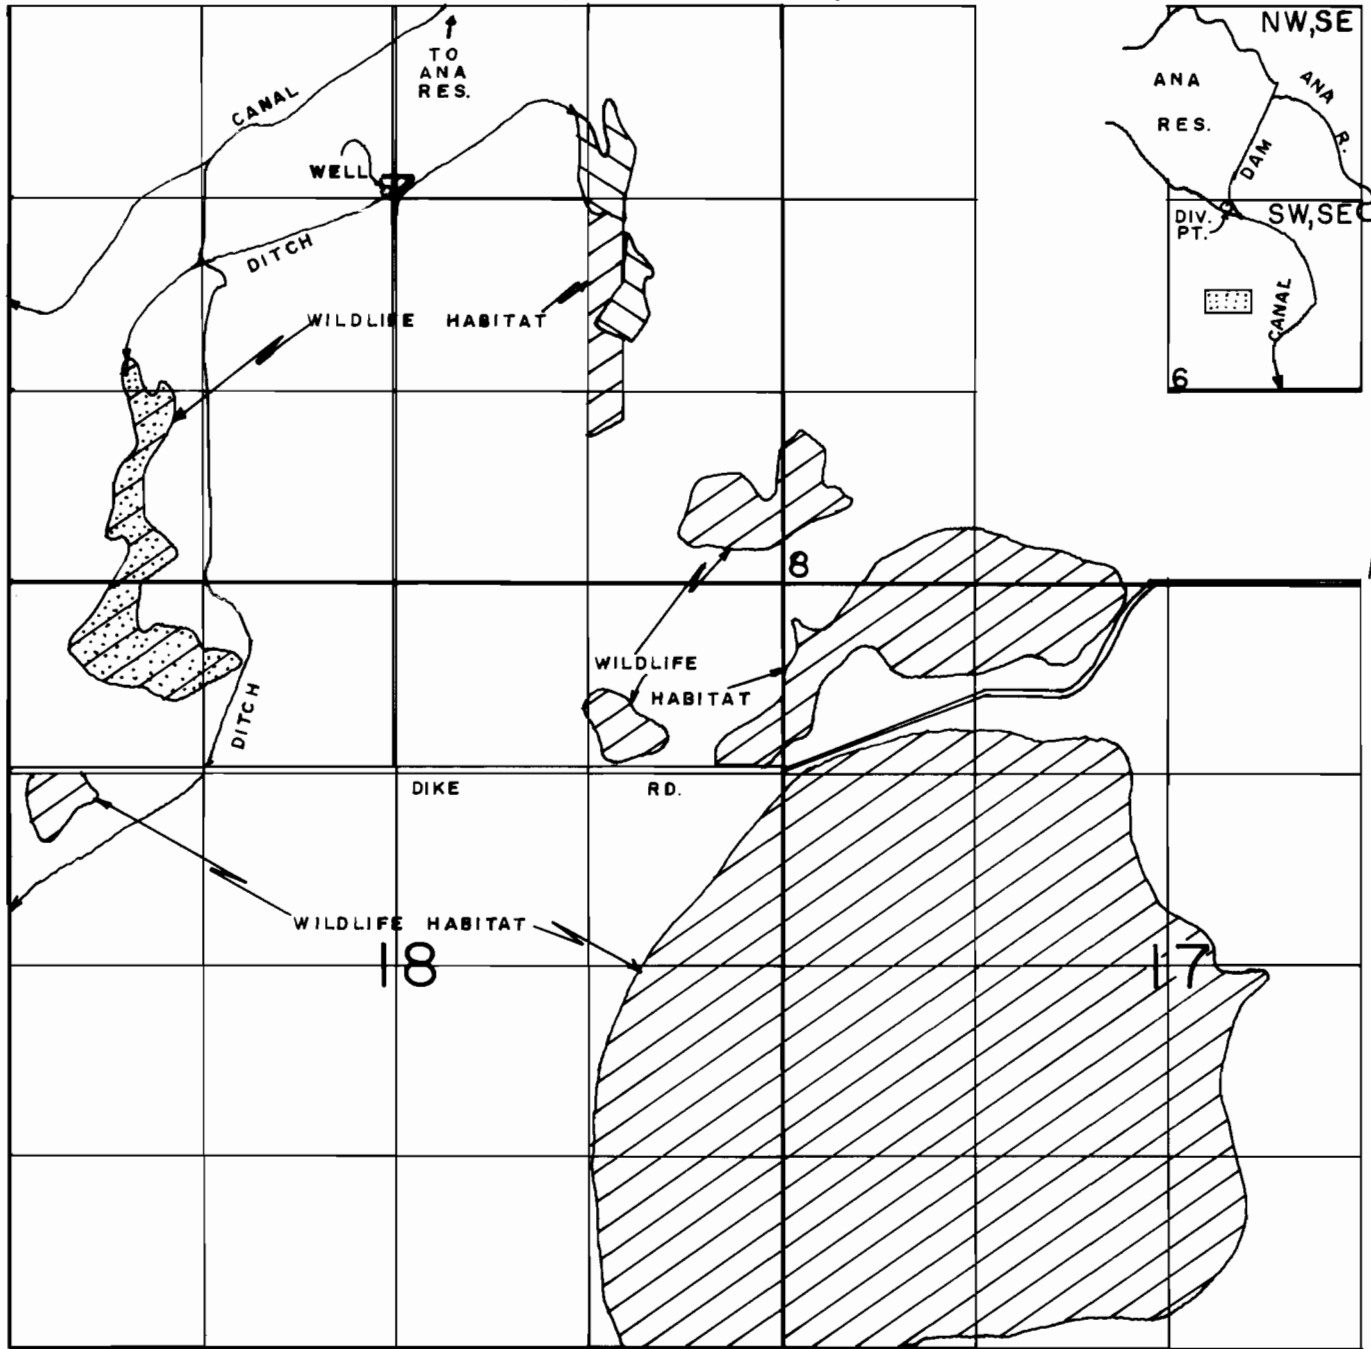

FINAL PROOF SURVEY

UNDER
 G-1558 G-10687
 G-10414 G-10433
 Application No. 68294 Permit No. 49352
 IN NAME OF

FEB 1994
 RESOURCE DIV.
 OREGON DEPT. OF FISH AND WILDLIFE

OREGON DEPARTMENT OF FISH AND WILDLIFE

Surveyed OCT 19, 1993, by R.M.SUTTERFIELD

WELL LOC: 30' N & 50' W FROM CEN COR. OF SEC 7.  
 DIV. PT. LOC: 1260' N & 2240' W FROM SE COR. OF SEC 6. 