

SECTION

Application No. 60598

Permit No. 46192

TOWNSHIP 39S, RANGE 20E, W. M.


46192  
82288

RECORDED

SEP 08 1980

WATER RESOURCES DEPT  
SALEM, OREGON

North

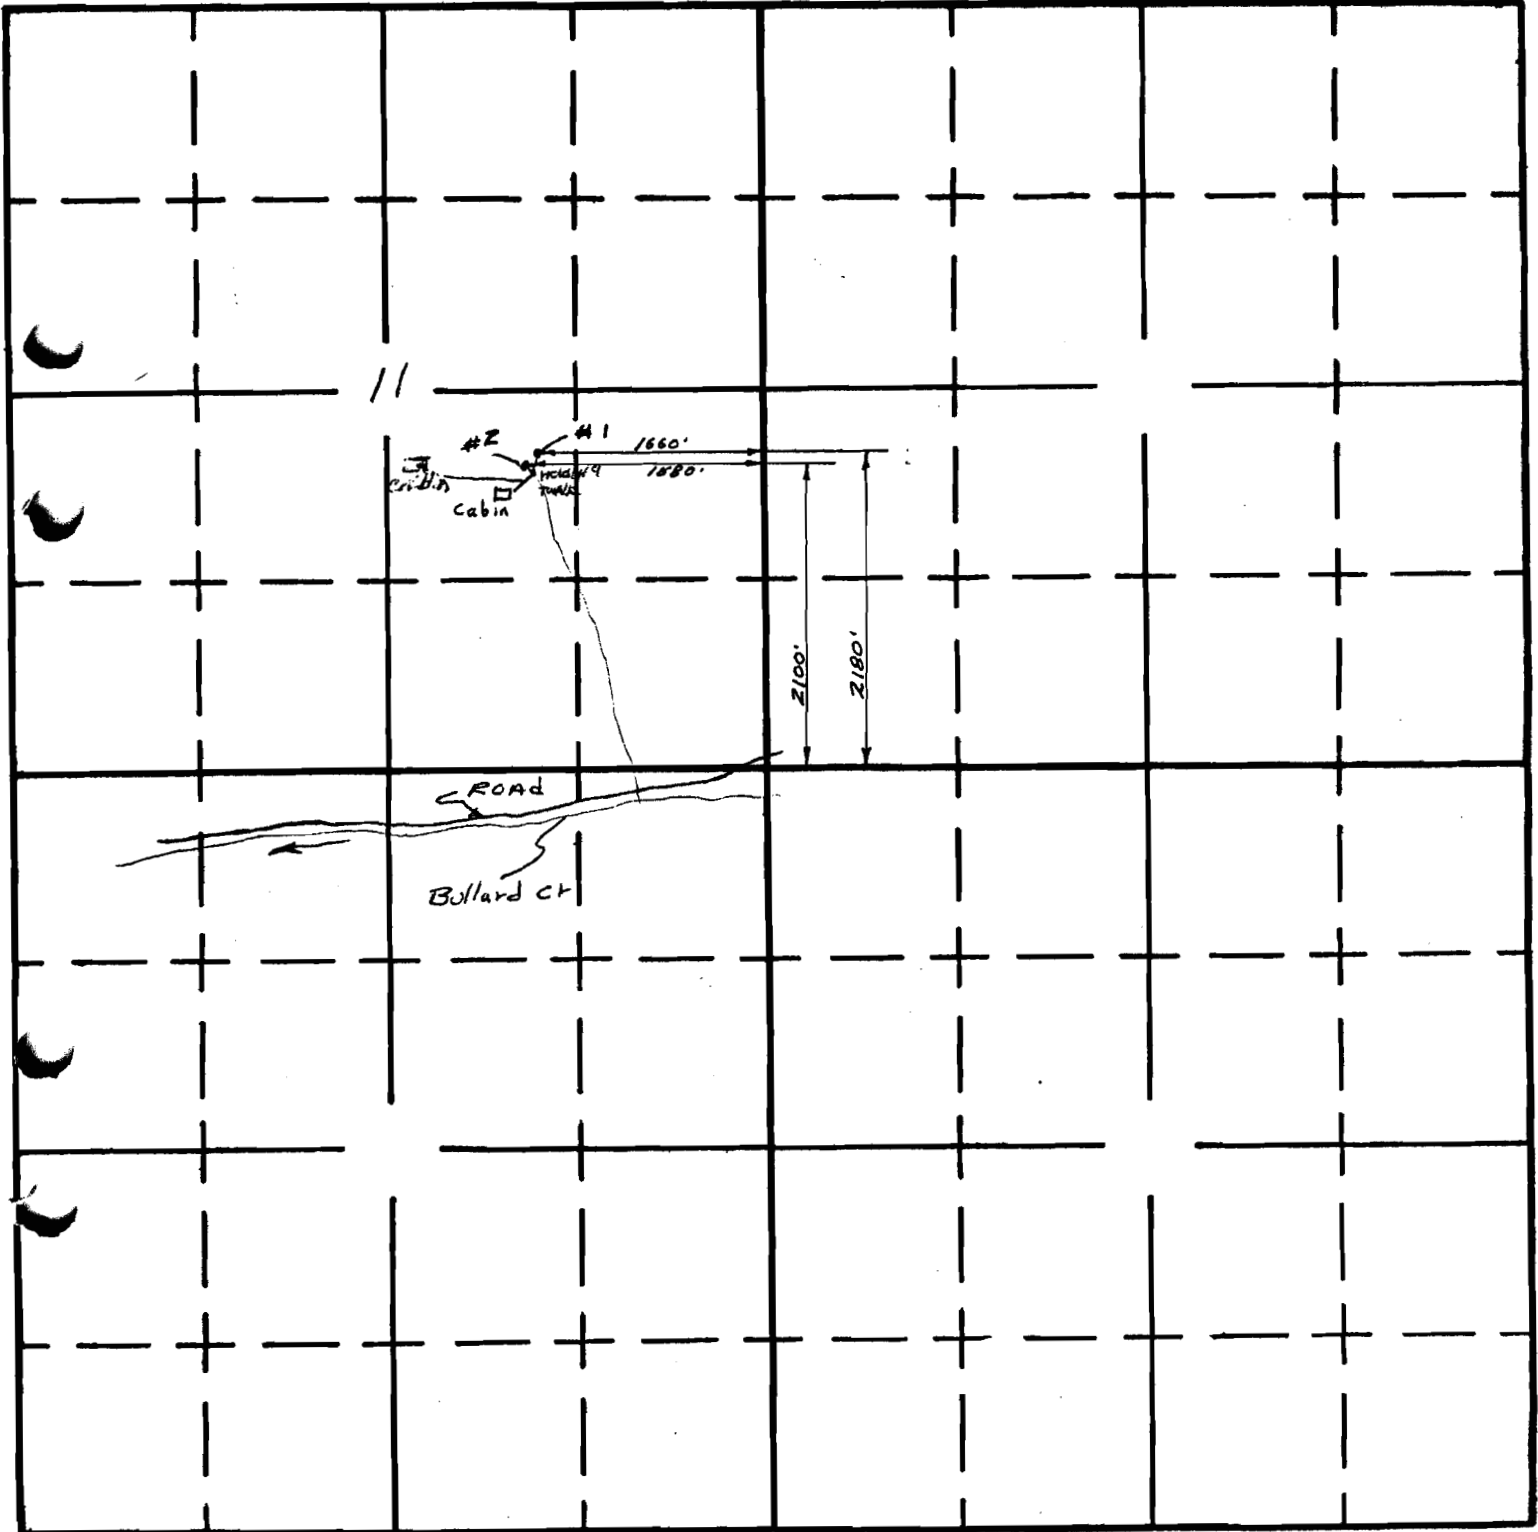

South

All information on this map furnished by applicant

Jim R. Johnston  
Applicant