


Township 13 and 14 South, Range 30 East, W.M.

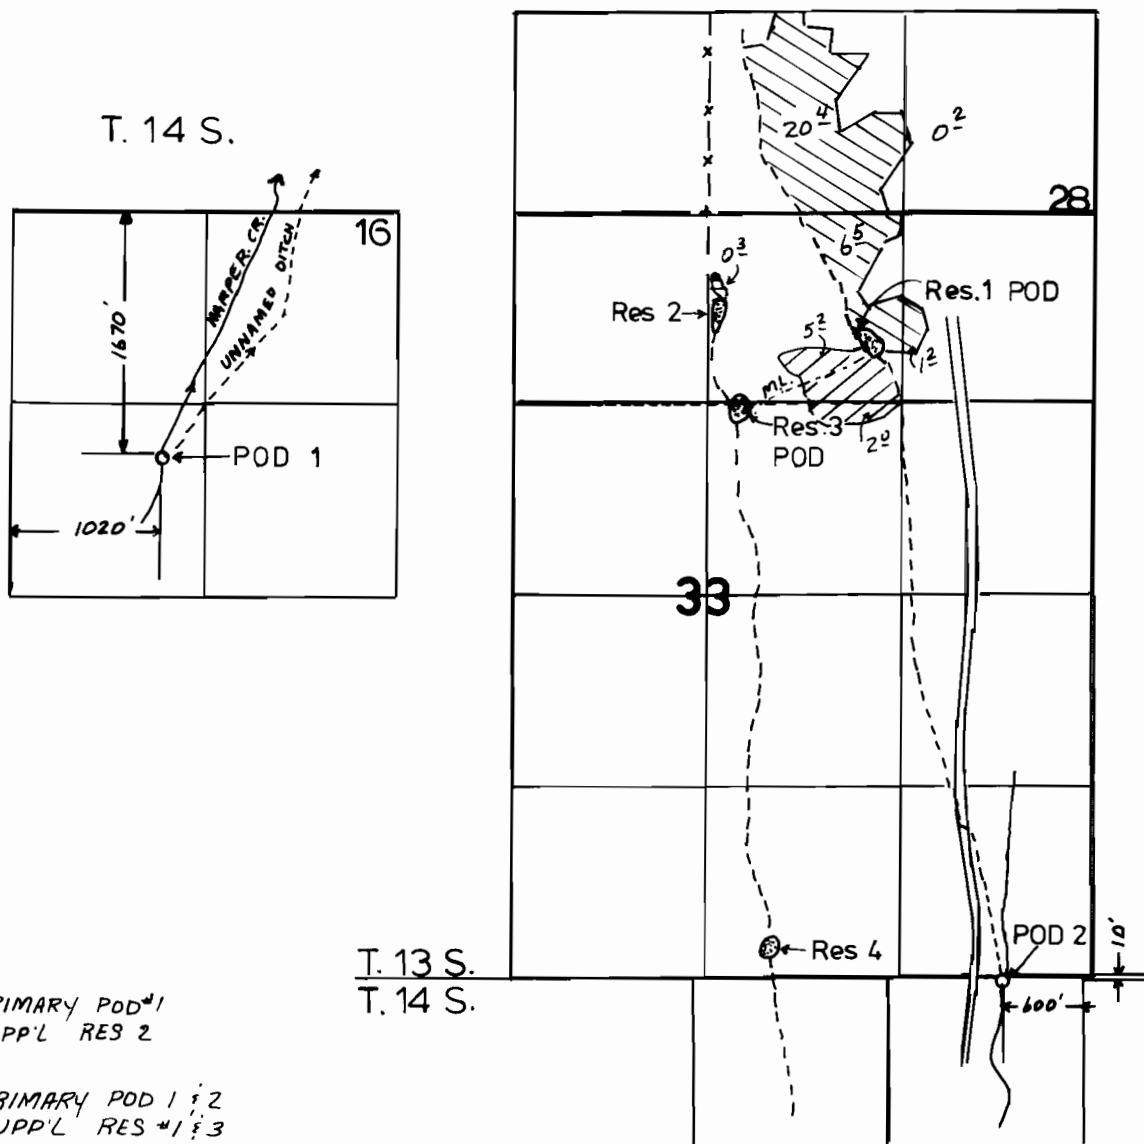

-  PRIMARY POD #1
SUPP'L RES 2
-  PRIMARY POD 1 & 2
SUPP'L RES #1 & 3
-  SUPP'L RES #1
-  RESERVOIRS

FINAL PROOF SURVEY UNDER

R 60967 R 8335
Application No. ...60968 Permit No. ...46298.....
IN NAME OF

.....INGLE BUTTE RANCHES, INC.....

Surveyed SEPT. 16, 1998, by J. MILLER.....