
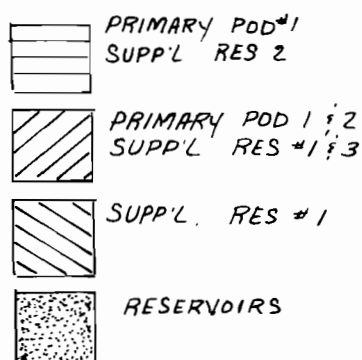


Township 13 and 14 South, Range 30 East, W.M.

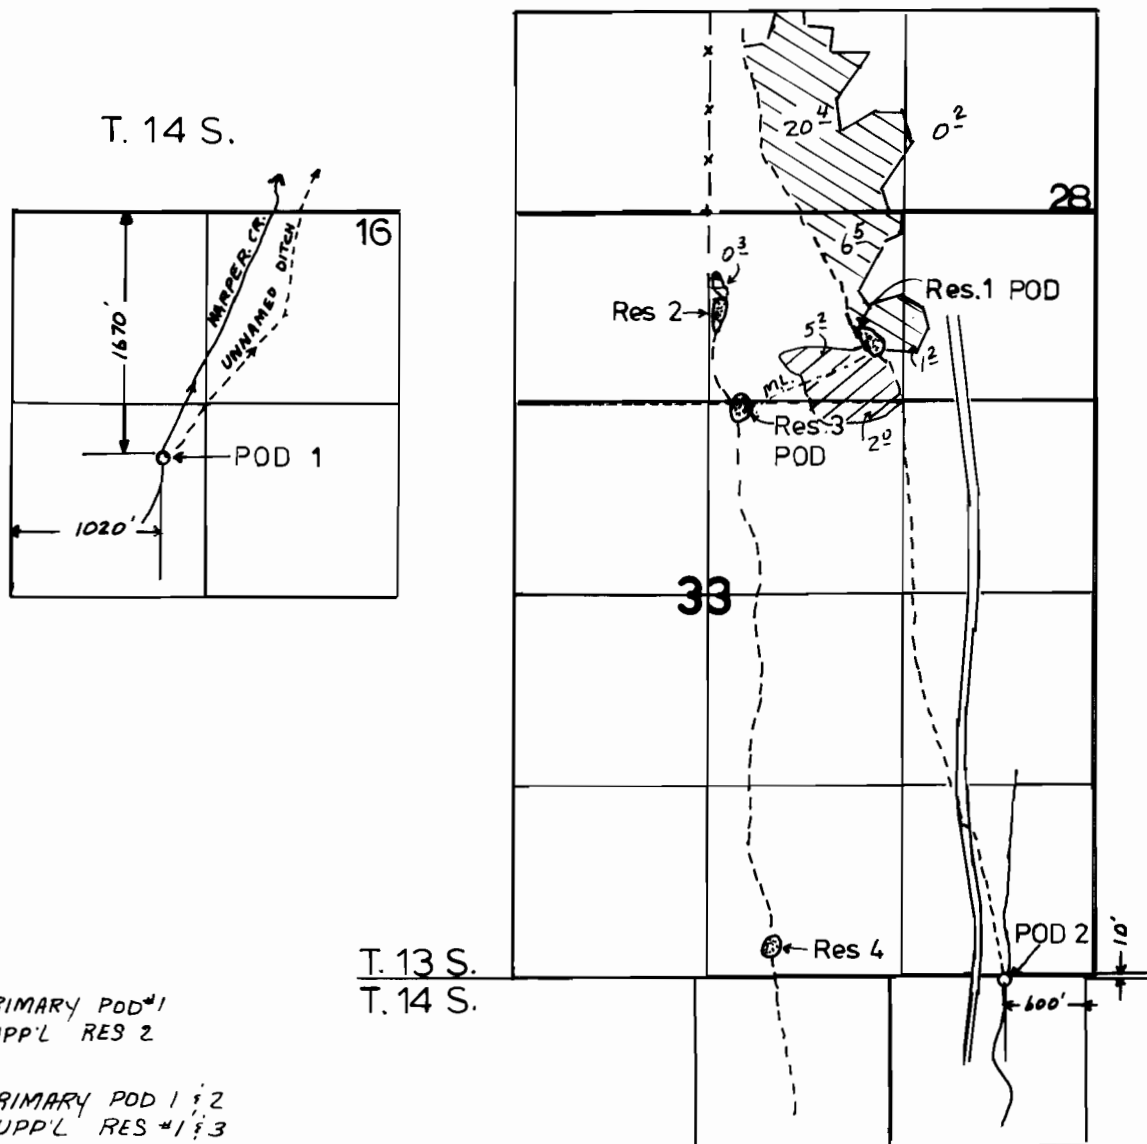

FINAL PROOF SURVEY UNDER

R 60967 R 8335
Application No. ...60968 Permit No. ...8335.....
IN NAME OF

.....INGLE BUTTE RANCHES, INC.....

Surveyed SEPT. 16, 1998, by J. MILLER.....