


T.8S., R. 27 E., W.M.

RECEIVED

JUL -1 1993

WATER RESOURCES DEPT.
SALEM, OREGON

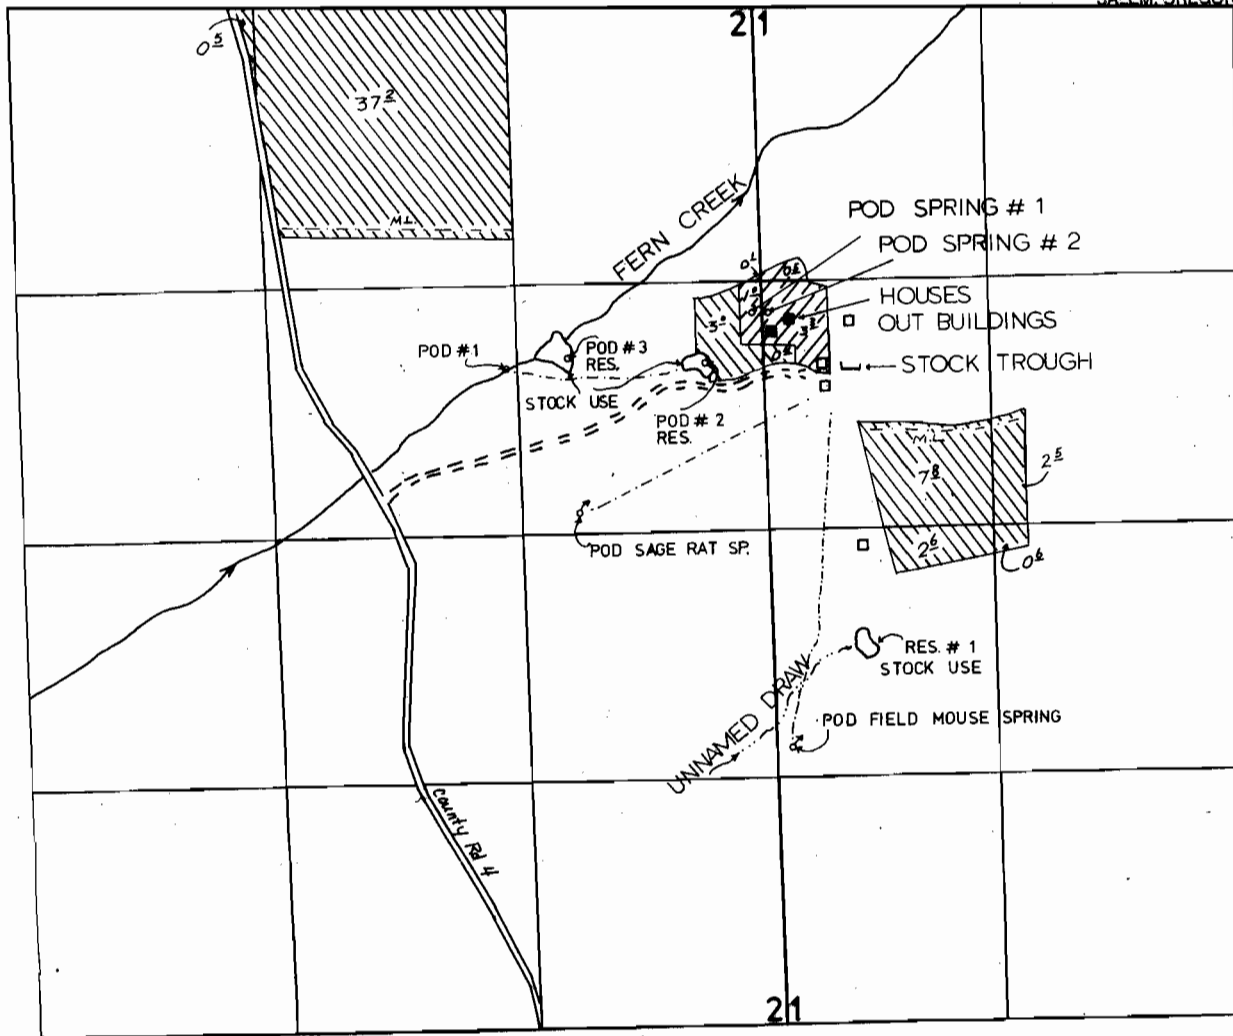

PERMIT 45464
POD- SPRING # 1, -1610' S. AND 50' W., SPRING# 2, -1615' S. AND 25' E., SAGE RAT SPRING -2675' S. AND 1000' W.,
FIELD MOUSE SPRING -3910' S. AND 75' E., ALL BEING FROM THE N.E. CORNER, SECTION 2.

PERMIT 45463
POD- RES. #2 -1870' S. AND 550' W., RES. #3 -1850' S. AND 1030' W., BOTH FROM THE N.E. CORNER, SECTION 2.
POD - FERN CREEK # 1 1900' S. AND 1360' W. FROM THE N.E. CORNER, SECTION 2.

PERMIT # 45463



PERMIT # 45464



FINAL PROOF SURVEY UNDER

Application No. 59391 Permit No. 45463
59392 45464
R-59390 R-8226

IN THE NAME OF

RALPH GANO MILLER

Surveyed JULY 22, 1994 by J. MILLER

1"= 660'