


T. 7 S., R. 35 1/2 E., W.M.

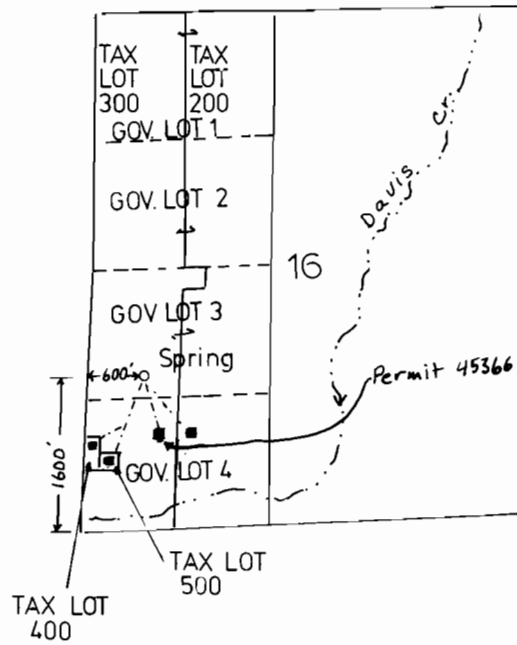

↑
N
1" = 2000'

FINAL PROOF SURVEY

UNDER

Application No. 52432 Permit No. 39434

IN NAME OF

DONALD MC KINNEY

Surveyed OCTOBER 22, 1992, by J. MILLER

August 17 2000 J. Miller