


T. 14 S., R. 30 E., W. M.

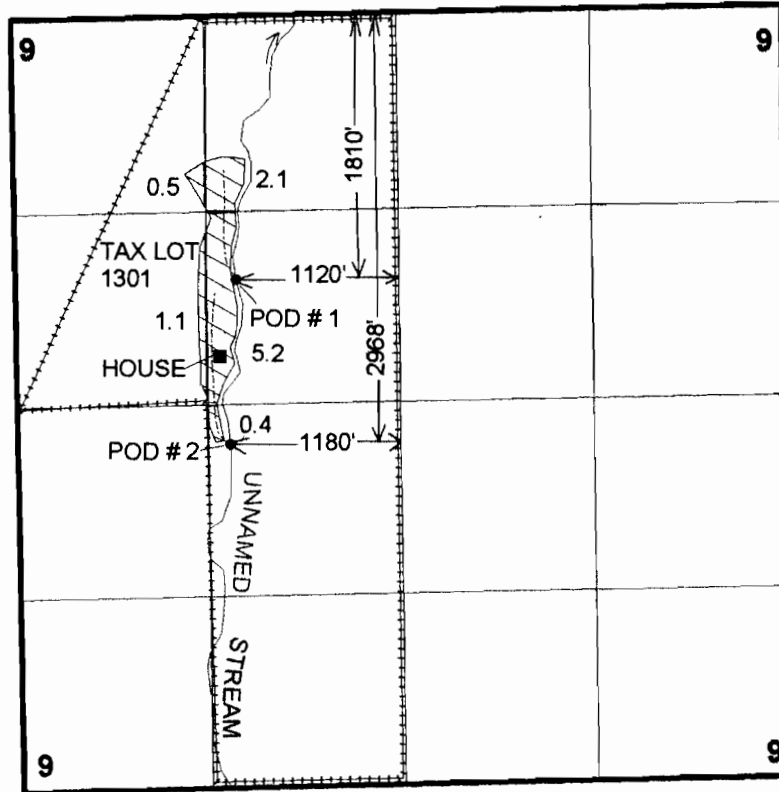

1" = 1320'

FINAL PROOF SURVEY

UNDER

Application 55471 Permit 42201

IN THE NAME OF

STEVE A. PARSONS

Surveyed October 16, 2000 by J. Miller

RECEIVED

OCT 30 2002

**WATER RESOURCES DEPT.
SALEM, OREGON**