


T. 7 S., R. 35 1/2 E., W.M.

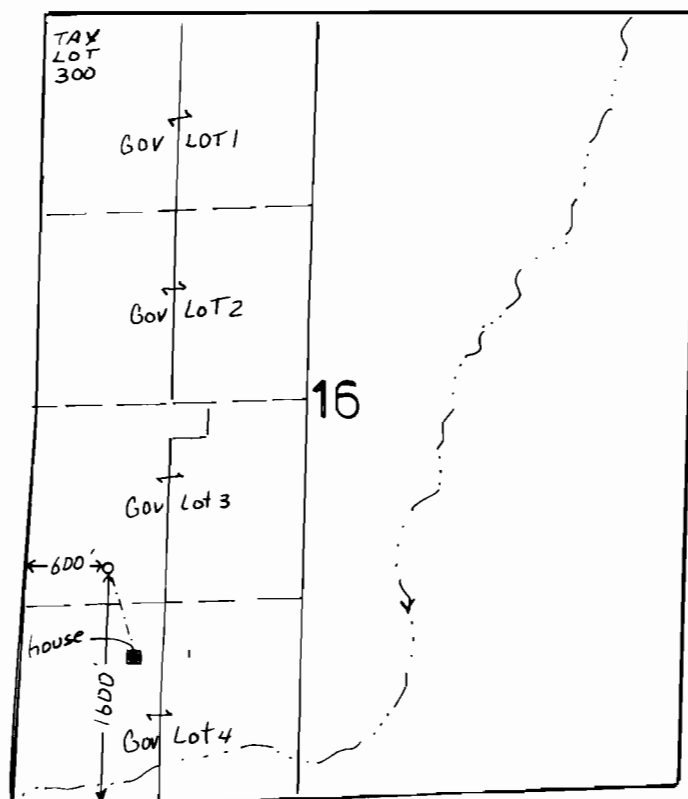

1" = 1320'

FINAL PROOF SURVEY

UNDER

Application No. 60671 Permit No. 45366

IN NAME OF

JOHN E. FRY

Surveyed OCTOBER 22, 1992, by J. MILLER

August 17, 2000 J. Miller